

U. S. DEPARTMENT OF THE INTERIOR

GEOLOGICAL SURVEY

Water Resources Division Well Schedule Form

MASTER CARD

Record by DAARONSON Source of data FILE Date 7/20/65 Map OAKLAND, IOWA 1:24,000

State IOWA County POTTAWATTAMIE Sequence number 1

Latitude: 41° 11' 8" N Longitude: 095° 29' 00" W

Lat-long accuracy: 2" T, 75" S, R, 40" E Sec 12 NE, NW, SW, SE

Local well number: 07540W12C6a Other number: W-0213

Local use: 00213 18 CITY Owner or name: OAKLAND DEPT. WELL

Owner or name: OAKLAND IOWA Address: OAKLAND, IOWA

Ownership: County, Fed Gov't, City, Corp or Co, Private, State Agency, Water Dist M

Use of: Air cond, Comm, Dewatering, Fire, Dom, Irr, Ind, Stock, Instl, Unused P

Use of: Anode, Drain, Seismic, Obs, Oil-gas, Recharge, Spring, Test, Unused, Withdraw, Waste, Destroyed W

Data available: Well data I Freq. W/L meas.: INTERMITTENT Field aquifer char. I

Hyd. lab. data: C

Qual. water data: type: COMPLETE

Freq. sampling: INTERMITTENT Pumpage inventory: yes I no, Period: YCN

Aperture cards: D

Log data: DRILLER'S LOG

WELL-DESCRIPTION CARD

SAME AS ON MASTER CARD Depth well: 1936 ft 1936 Meas. accuracy 1/8

Depth cased: 1936 ft 1936 Casing type: STEEL Diam. 16 in

Finish: porous gravel w. gravel w. horiz. open perf., screen, sd. pt., shored, open concrete, (perf.), (screen), gallery, end, other I

Method: (A) (B) (C) (D) (H) (J) (P) (R) (T) (V) (W) (Z) I

Drilled: air bored, cable, dug, hyd jetted, air reverse trenching, driven, drive rot., rot., percussion, rotary, wash, other I

Date Drilled: 1918 9/18 Pump intake setting: 230 ft 230

Driller: THORPE BROS. WELLS DES MOINES, IOWA

Life: (A) (B) (C) (J) (L) (M) (N) (P) (R) (S) (T) (Z) Deep D Shallow I

(type): air, bucket, cent, jet, multiple, multiple, none, piston, rot, submerg, turb, other

Power: nat LFG Trans. or meter no. I

(type): diesel, elec, gas, gasoline, hand, gas, wind, H.P.

Descrip. MP LSO ft above below 1st, Alt. MP 1077

Alt. LSD: 1077 Accuracy: ALTIMETER

Water Level: 92 ft above below MP; Ft below 1st 92 Accuracy: REPORTED

Date: 1918 1/8 Yield: 150 gpm 150 Method determined I

Drawdown: 66 ft 66 Accuracy: REPT. 6 Pumping period hrs

QUALITY OF WATER DATA: Iron 27.0 Sulfate 682 Chloride 242 Hard. 282

Sp. Conduct 2840 K x 10⁶ Temp. 68 Date sampled FEB, 1962 2/6/2

Taste, color, etc. PARTICLES ON RECEIPT IN LAB.

075-40W-12 c 6a

Well Number 41.18.36 ^N 095.24.00

HYDROGEOLOGIC CARD

SAME AS ON MASTER CARD
 Physiographic Province: CENTRAL LOWLAND 1:2 Section: DISSECTED
 TILL PLAIN E Drainage Basin: ALANABOTANA 35:0 Subbasin:
 Topo of (O) (F) (H) (S) (T) (V)
 well site: local depression, flat surface, hilltop, hillside, terrace, valley flat,
 MAJOR Aquifer: DEVUNIAN, MIDDLE D:2 VAPSPINKON M:W
 system series aquifer, formation, group
 Lithology: DOLOMITE D Origin: MARINE 6 Aquifer Thickness: 85 ft
 Length of well open to: 1840 ft A:8:1
 MINOR Aquifer:
 system series aquifer, formation, group
 Lithology:
 Length of well open to:
 Intervals Screened:
 Depth to consolidated rock: 62 ft 6:2 Source of data: DRILLER'S LOG 1:1
 Depth to basement:
 Surface material: SANDY TILL R:1:1 Infiltration characteristics: POOR 7:7
 Coefficient Trans:
 Coefficient Storage:
 Permeability:
 Specific capacity: 2.2 gpm/ft; Number of geologic cards:

CASING:

65' OF 16" PIPE 0-65'


12" TO 460'

10" TO 960'

8" TO 1090'

7" TO 1608'

5" TO BOTTOM

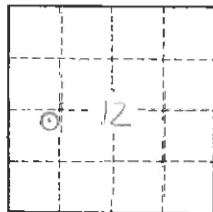

Oakland City Well W-0213

Dolo, com, dense, calc; dolo, brn, fn gran; cht, Hgr, up
H brn, v. fn, gran; Cht, Hgr, mot, subtransl

XX

Dolo drb, fn xfln-gran

Cht Hgr, subtransl, conch

mol brn, fn gran-xfln

Cht, brn mol wh

Dolo, dk brn fn xfln

Cht, brn mol wh, much glass, banded

Oakland (Pottawattamie)
Oakland City




IOWA GEOLOGICAL SURVEY
In Cooperation with U. S. Geological Survey

W-0213

RECORD OF WELL

Location:

Town: Oakland (N E)
(S W); County Pottawattamie
NE 1/4 NW 1/4 SW 1/4 sec. 12 T. 75 N., R. 40 W. Belknap Twp.

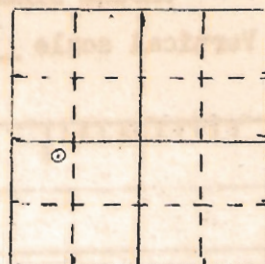

Well name and number Oakland deep city well

Owner City of Oakland Address _____

Tenant _____ Address _____

Contractor Thorpe Bros. Well Co. Address Des Moines

Drillers _____

Drilling dates 1917-1918

Well data:

Elevations: Drilling curb 1077 feet; Land surface _____ feet

Determined by _____

Topographic position small valley

Total depth: Reported 1936 feet; Measured _____ feet

Drilling method _____

Hole and casing data 65' of 16-inch casing to 65', 12" casing to 460', 10-inch casing to 960', 8-inch casing to 1090', 7-inch casing to 1608' and 5-inch casing to 1936'
(Give amount, size, kind, and depth of all casing; type and position of seals and packers; cementing; how finished--perforated pipe, screen, gravel pack, open hole, etc.)

Original depth to water 92 ft. ^{above} Land Surface Date 1918

Original elevation of water level 985 ft.; Source of data Vol 33 I.G.S.

Sources of water: Principal 1840-1925; Others only seeps

found above

Production data:

Date _____

Static depth to water 92; Measuring point Land Surface?Pumping level 158 at 150 g.p.m.Specific capacity 2.3 g.p.m. per ft. drawdown; Temperature _____ °F.

Pump data: Type pump _____; Column: Dia. _____ Length _____

Cylinder or bowls: Dia. _____ Length _____; Suction pipe _____

Power _____; Airline _____

Estimated rate of production: _____ g.p.m. for _____ hrs. a day

Use of water _____

WATER ANALYSES (in parts per million)

Date sampled	_____	_____	_____	_____
Sampled by	_____	_____	_____	_____
Total solids	_____	_____	_____	_____
Insoluble matter	_____	_____	_____	_____
Alkalinity (Meo)	_____	_____	_____	_____
Alkalinity (Phn)	_____	_____	_____	_____
pH	_____	_____	_____	_____
Fe ₂ O ₃ +Mn ₂ O ₃ +Al ₂ O ₃	_____	_____	_____	_____
Alkali as sodium	_____	_____	_____	_____
Calcium	_____	_____	_____	_____
Magnesium	_____	_____	_____	_____
Iron (unfiltered)	_____	_____	_____	_____
Manganese	_____	_____	_____	_____
Nitrate	_____	_____	_____	_____
Fluoride	_____	_____	_____	_____
Chloride	_____	_____	_____	_____
Sulphate	_____	_____	_____	_____
Bicarbonate	_____	_____	_____	_____
Hardness (ppm)	_____	_____	_____	_____
Hardness (gpg)	_____	_____	_____	_____
Remarks	_____			

Laboratory data:

Sample storage location _____

Sample range 1150-1932 No. spls. 75 No. dupls & cond. _____

Spls. prepared by _____ Washed range _____ by _____

Driller's log and cond. _____

Insoluble residues: Prepared by _____ Studied by _____ Strip log _____

Microscopic study Oliver strip log _____

Gen. log _____ Correl. by _____

Casing record at Oakland City well

T.D. 1936 drilled 1917-18.

65' of 16-inch pipe 0-65'

12-inch to 460 feet

10-inch to 960 feet

8-inch to 1090 feet

7-inch to 1608 feet

5-inch to bottom

No water except seep until 1840 where for 30' cuttings washed away.

Water 1840 to 1925'

Equip. 2070 to 2155

SWI 92 ft

Pumping test 150 g.p.m. with 66 ft dd. with cylinder at 230 ft

STATE OF IOWA
IOWA GEOLOGICAL SURVEY
GEOLOGY ANNEX
IOWA CITY

OAKLAND, POTTAWATTAMIE COUNTY

Well curb - 1077

The city well, drilled by the Thorpe Brothers Well Company of Des Moines, is 1936 feet in depth and its diameters are from 16 to 7 inches. The well is cased with 16 inch pipe to 65 feet, 12 inch to 460 feet, 10 inch to 960 feet, 8 inch to 1090 feet, 7 inch to 1608, and 5 inch to the bottom. The well was drilled in 1917-18.

"No water except seep was found until the depth of 1840 feet was reached where for 30 feet cuttings were washed away. Water was found in this bed of creviced dolomite from 1840 to 1925 feet. The static level is 92 feet from the surface and at the final test pumping at the rate of 150 gallons per minute produced a draw down of 66 feet with the cylinder at 230 feet." The cost of the well was \$16,875

Driller's log and Record of strata

	<u>Depth in feet</u>
Pleistocene and Recent (62 feet thick; top 1077 feet above sea level):	
"Sandy clay"	0-10
"Sand"	10-35
"Sandy clay"	35-62
Pennsylvanian:	
Missouri series (393 feet thick)—	
"Lime rock and shale"	62-455
Des Moines series (635 feet thick)—	
"Shale with streaks of sandstone"	445-1090
Mississippian and other formations (top 12 feet above sea level):	
"Limestone"	1090-1486
Limestone, light yellow-gray and light blue-gray, rapid effervescence in cold dilute HCl; flakes and poorly rounded grains of limpid quartz; whitish cryptocrystalline silica; cuttings in sand and powder	1130
Limestone, gray, rapid effervescence	1140
Limestone, gray, fine grained, rapid effervescence, buff, moderately rapid; a little blue shale in minute chips, siliceous with irregular grains and minute particles of clear quartz and cryptocrystalline silica	1150
Limestone, blue-gray, effervescence moderately rapid; white, crystalline, rapid reaction, fine-grained, a little shale	1160

	<u>Depth in feet</u>
Shale, greenish, calcareous; limestone, effervescence rapid, blue-gray; chalcedony and clear quartz; a little brown shale	1170
Limestone as above; silica as above; a little shale	1180
Limestone, blue and brownish gray, effervescence moderately rapid, argillaceous; dark flint, chalcedony; 3 samples	1190-1210
Limestone, light brown, hard, siliceous, response slow; some rapid; silica as above	1220
Limestone, as above; some green shale; pyrite	1230
Shale, greenish, calcareous, in chips	1240
Limestone, light gray, response rapid; shale in minute chips; whitish silica; pyrite	1250
Limestone, gray, rapid reaction; white silica; black fissile shale at 1260 and 1280; 3 samples	1260-1280
Shale, drab; white chalcedonic silica; limestone, gray	1290
Shale, dark drab, fissile	1300
Shale, as above; limestone	1310
Limestone, response rapid; chert; chalcedonic silica; shale; pyrite	1320
Shale, blue	1330
Limestone, buff, in sand; chips of shale	1340
Shale and limestone, light buff, in fine sand; limpid quartz and cryptocrystalline silica	1350, 1360
Shale, blue, in powder; some limestone and cryptocrystalline silica; 3 samples	1370-1400
Limestone, buff, moderately rapid reaction; much cryptocrystalline silica in minute flakes and crystalline quartz in microscopic particles	1410
Sandstone, fine, grains imperfectly rounded	1420
Shale, blue, in chips	1430
Limestone, effervescence rapid, buff; cryptocrystalline silica and quartz	1440-1450

	<u>Depth in feet</u>
Limestone, light yellow-gray, rapid response, a little silica as above	1460
Shale, blue, in fine sand	1463-1467
Limestone, light buff, effervescence rapid; sandstone, some shale	1470
Limestone, light buff, slow effervescence	1480
Driller's log; "shale (Kinderhook?)"	1486-1583
Limestone, light buff, some slow, some rapid reaction; chalcedony and quartz sand; shale in powder and chips	1500
Shale, light blue, calcareous; 2d sample at	1500
Shale, blue, calcareous; 4 samples	1510-1540
Limestone, light yellow-gray, effervescence rapid; some chips of shale	1550
Limestone, as above; shale, blue, some bright green	1560
Limestone, as above, in flaky chips, earthy	1570
Limestone, as above, in small chips	1580
Limestone, gray, some whitish, rapid effervescence	1590, 1600
Dolomite, light blue-gray, crystalline	1610
Limestone, light buff and whitish, effervescence rapid, called "hard" by driller	1620
Limestone, buff, in fine sand, some rapid effervescence, some darker and rather slow, considerable residue of quartzose microscopic particles and some grains of limpid quartz; blue shale, pyrite	1630
Limestone, gray, reaction moderately rapid, "hard"	1640
Limestone, blue-gray, moderately slow reaction, argillaceous	1650
Limestone and shale, limestone brown, moderately slow reaction	1660
Shale and limestone, blue-gray, reaction slow; at 1680 also white and gray cryptocrystalline silica and microscopic quartz particles	1670, 1680
Dolomite, light blue and gray, cuttings in fine sand and flour, much chalcedonic silica and some fine quartz sand; 3 samples	1690, 1710

	<u>Depth in feet</u>
Shale, blue-gray, with dolomite and silica as above	1720
Silica, white, chalcedonic; whitish limestone of rapid effervescence; fine quartz sand; all in powder and sand	1730
Shale, light blue-gray, siliceous as above, calcareous	1740
Dolomite, in powder and fine meal; shale, light blue-gray, in powder, quartzose	1750
Dolomite, gray, in fine crystalline sand; cuttings blue-gray in mass from argillaceous powder	1760
Dolomite, buff and gray, in fine crystalline sand; 6 samples	1770-1820
Dolomite, light yellow-gray; some flakes of blackish fossiliferous shale, inflammable, similar in appearance to that at 1280	1830, 1840
No samples, "drillings washed away"	1840-1870
Dolomite, subcrystalline, light yellowish and light brownish gray, in chips; some shale as above	1870
Dolomite, and some magnesian limestone of rather slow effervescence; light yellow-gray; considerable calcite	1927
Dolomite, light buff, in clean fine meal	1932

Oakland, Pottawattamie County
 (Altitude 1102 feet)

Copied from I.G.S. Vol 33, pp. 296-298

The city well, drilled by the Thorpe Brothers Well Company of Des Moines, is 1936 feet in depth and its diameters are from 16 to 7 inches. The well is cased with 16 inch pipe to 65 feet, 12 inch to 460 feet, 10 inch to 960 feet, 8 inch to 1090 feet, 7 inch to 1608, and 5 inch to the bottom.

No water except seep was found until the depth of 1840 feet was reached where for 30 feet cuttings were washed away. Water was found in this bed of creviced dolomite from 1840 to 1925 feet. The static level is 92 feet from the surface and at the final test pumping at the rate of 150 gallons per minute produced a drawdown of 66 feet with the cylinder at 230 feet. The cost of the well was \$16,875.

Driller's log and Record of strata

	Depth in Feet
PLEISTOCENE AND RECENT (62 ft. thick; top 1102 ft. above sea level);	
"Sandy clay"	0-10
"Sand"	10-35
"Sandy clay"	35-62
PENNSYLVANIAN:	
Missouri series (393 feet thick)	
"Lime rock and shale"	62-455
Des Moines series (635 feet thick)	
"Shale with streaks of sandstone"	455-1090
MISSISSIPPIAN AND OTHER FORMATIONS (top 12 ft. above sea level)	
"Limestone"	1090-1486
Limestone, light yellow-gray and light blue-gray, rapid effervescence in cold dilute HCl; flakes and poorly rounded grains of limpid quartz; whitish cryptocrystalline silica; cuttings in sand and powder	1130
Limestone, gray, rapid effervescence	1140
Limestone, gray, fine grained, rapid effervescence, buff, moderately rapid; a little blue shale in minute chips, siliceous with irregular grains and minute particles of clear quartz and cryptocrystalline silica	1150
Limestone, blue-gray, effervescence moderately rapid; white, crystalline, rapid reaction, fine-grained; a little shale	1160
Shale, greenish, calcareous; limestone, effervescence rapid, blue-gray; chalcedony and clear quartz; a little brown shale	1170
Limestone as above; silica as above; a little shale	1180


	Depth in Feet
Limestone, blue and brownish gray, effervescence moderately rapid, argillaceous; dark flint, chalcedony; 3 samples	1190-1210
Limestone, light brown, hard, siliceous, response slow; some rapid; silica as above	1220
Limestone, as above; some green shale; pyrite	1230
Shale, greenish, calcareous, in chips	1240
Limestone, light gray, response rapid; shale in minute chips; whitish silica; pyrite	1250
Limestone, gray, rapid reaction; white silica; black fissile shale at 1260 and 1280; 3 samples	1260-1280
Shale, drab; white chalcedonic silica; limestone, gray	1290
Shale, dark drab, fissile	1300
Shale, as above; limestone	1310
Limestone, response rapid; chert; chalce- donic silica; shale; pyrite	1320
Shale, blue	1330
Limestone, buff, in sand; chips of shale	1340
Shale and limestone, light buff, in fine sand; limpid quartz and cryptocrystalline silica	1350, 1360
Shale, blue, in powder; some limestone and cryptocrystalline silica; 3 samples	1370-1400
Limestone, buff, moderately rapid reaction; much cryptocrystalline silica in minute flakes and crystalline quartz in micro- scopic particles	1410
Sandstone, fine, grains imperfectly rounded	1420
Shale, blue, in chips	1430
Limestone, effervescence rapid, buff; crypto- crystalline silica and quartz	1440-1450
Limestone, light yellow-gray, rapid response; a little silica as above	1460
Shale, blue, in fine sand	1463-1467
Limestone, light buff, effervescence rapid; sandstone; some shale	1470
Limestone, light buff, slow effervescence	1480
Driller's log; "shale (Kinderhook?)"	1486-1583
Limestone, light buff, some slow, some rapid reaction; chalcedony and quartz sand; shale in powder and chips	1500
Shale, light blue, calcareous; 2d sample at	1500
Shale, blue, calcareous; 4 samples	1510-1540
Limestone, light yellow-gray, effervescence rapid; some chips of shale	1550
Limestone, as above; shale, blue, some bright green	1560
Limestone, as above, in flaky chips, earthy	1570
Limestone, as above, in small chips	1580
Limestone, gray, some whitish, rapid effervescence	1590, 1600

	Depth in Feet
Dolomite, light blue-gray, crystalline	1610
Limestone, light buff and whitish, effervescence rapid, called "hard" by driller	1620
Limestone, buff, in fine sand, some rapid effervescence, some darker and rather slow, considerable residue of quartzose micro- scopic particles and some grains of limpid quartz; blue shale, pyrite	1630
Limestone, gray, reaction moderately rapid; "hard"	1640
Limestone, blue-gray, moderately slow reaction, argillaceous	1650
Limestone and shale, limestone brown, moderately slow reaction	1660
Shale and limestone, blue-gray, reaction slow; at 1680 also white and gray crypto- crystalline silica and microscopic quartz particles	1670, 1680
Dolomite, light blue and gray, cuttings in fine sand and flour, much chalcedonic silica and some fine quartz sand; 3 samples	1690-1710
Shale, blue-gray, with dolomite and silica as above	1720
Silica, white, chalcedony; whitish lime- stone of rapid effervescence; fine quartz sand; all in powder and sand	1730
Shale, light blue-gray, siliceous as above calcareous	1740
Dolomite, in powder and fine meal; shale, light blue-gray, in powder, quartzose	1750
Dolomite, gray, in fine crystalline sand; cuttings blue-gray in mass from argillaceous powder	1760
Dolomite, buff and gray, in fine crystalline sand; 6 samples	1770-1820
Dolomite, light yellow-gray, some flakes of blackish fossiliferous shale, inflammable, similar in appearance to that at 1280	1830, 1840
No samples, "drillings washed away"	1840-1870
Dolomite, subcrystalline, light yellowish and light brownish gray, in chips; some shale as above	1870
Dolomite, and some magnesian limestone of rather slow effervescence; light yellow- gray; considerable calcite	1927
Dolomite, light buff, in clean fine meal	1932


Notes.-- The floor of the Coal Measures, placed by the above interpretation of the driller's log at 12 feet above sea level, is in accord with the elevation of this floor at points north, east and south where it has been reached. About 25 miles to the west in the Council Bluffs-Omaha area the altitude at the floor as defined by the summit of heavy limestones referred to the Mississippian stands 550 feet above sea level, indicating a rather sharp upwarp toward the west, if not faulting.

The Oakland well reaches a depth of 730 feet below sea level. No evidence of the Saint Peter sandstone or of its superincumbent shales is found in the cuttings and the sandstone probably lies 200 or 300 feet below the bottom of the well. The dolomites in which the well foots may be referred to the Galena with some probability.


Location Pottsville, Pa. Date Drilled _____ Analyst M. E. Hays

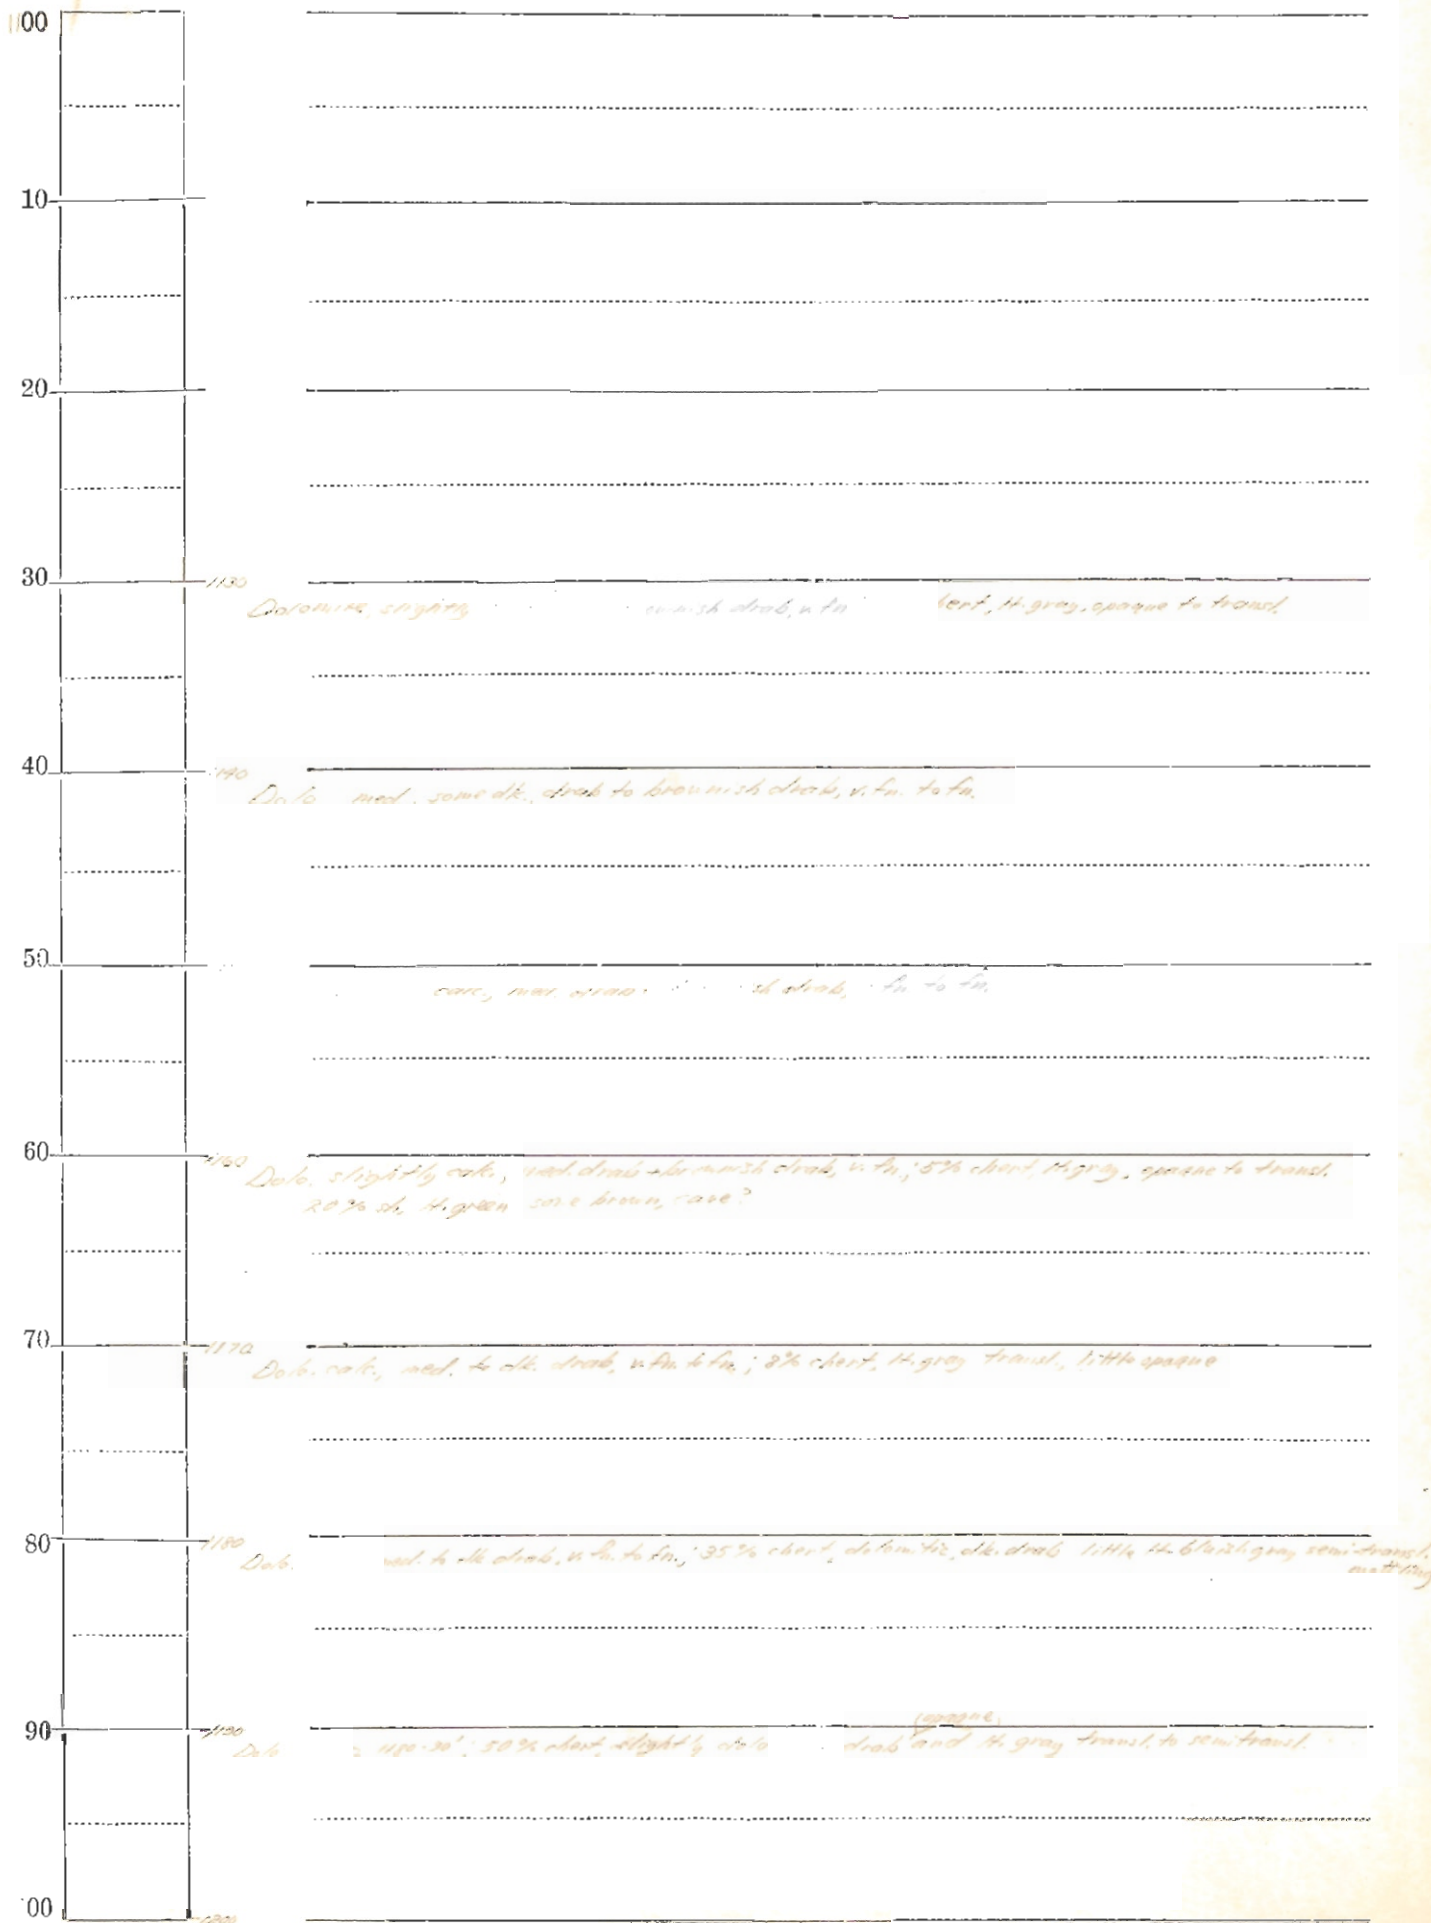


Location Pottawatomie Date Drilled Analyst M. Elias

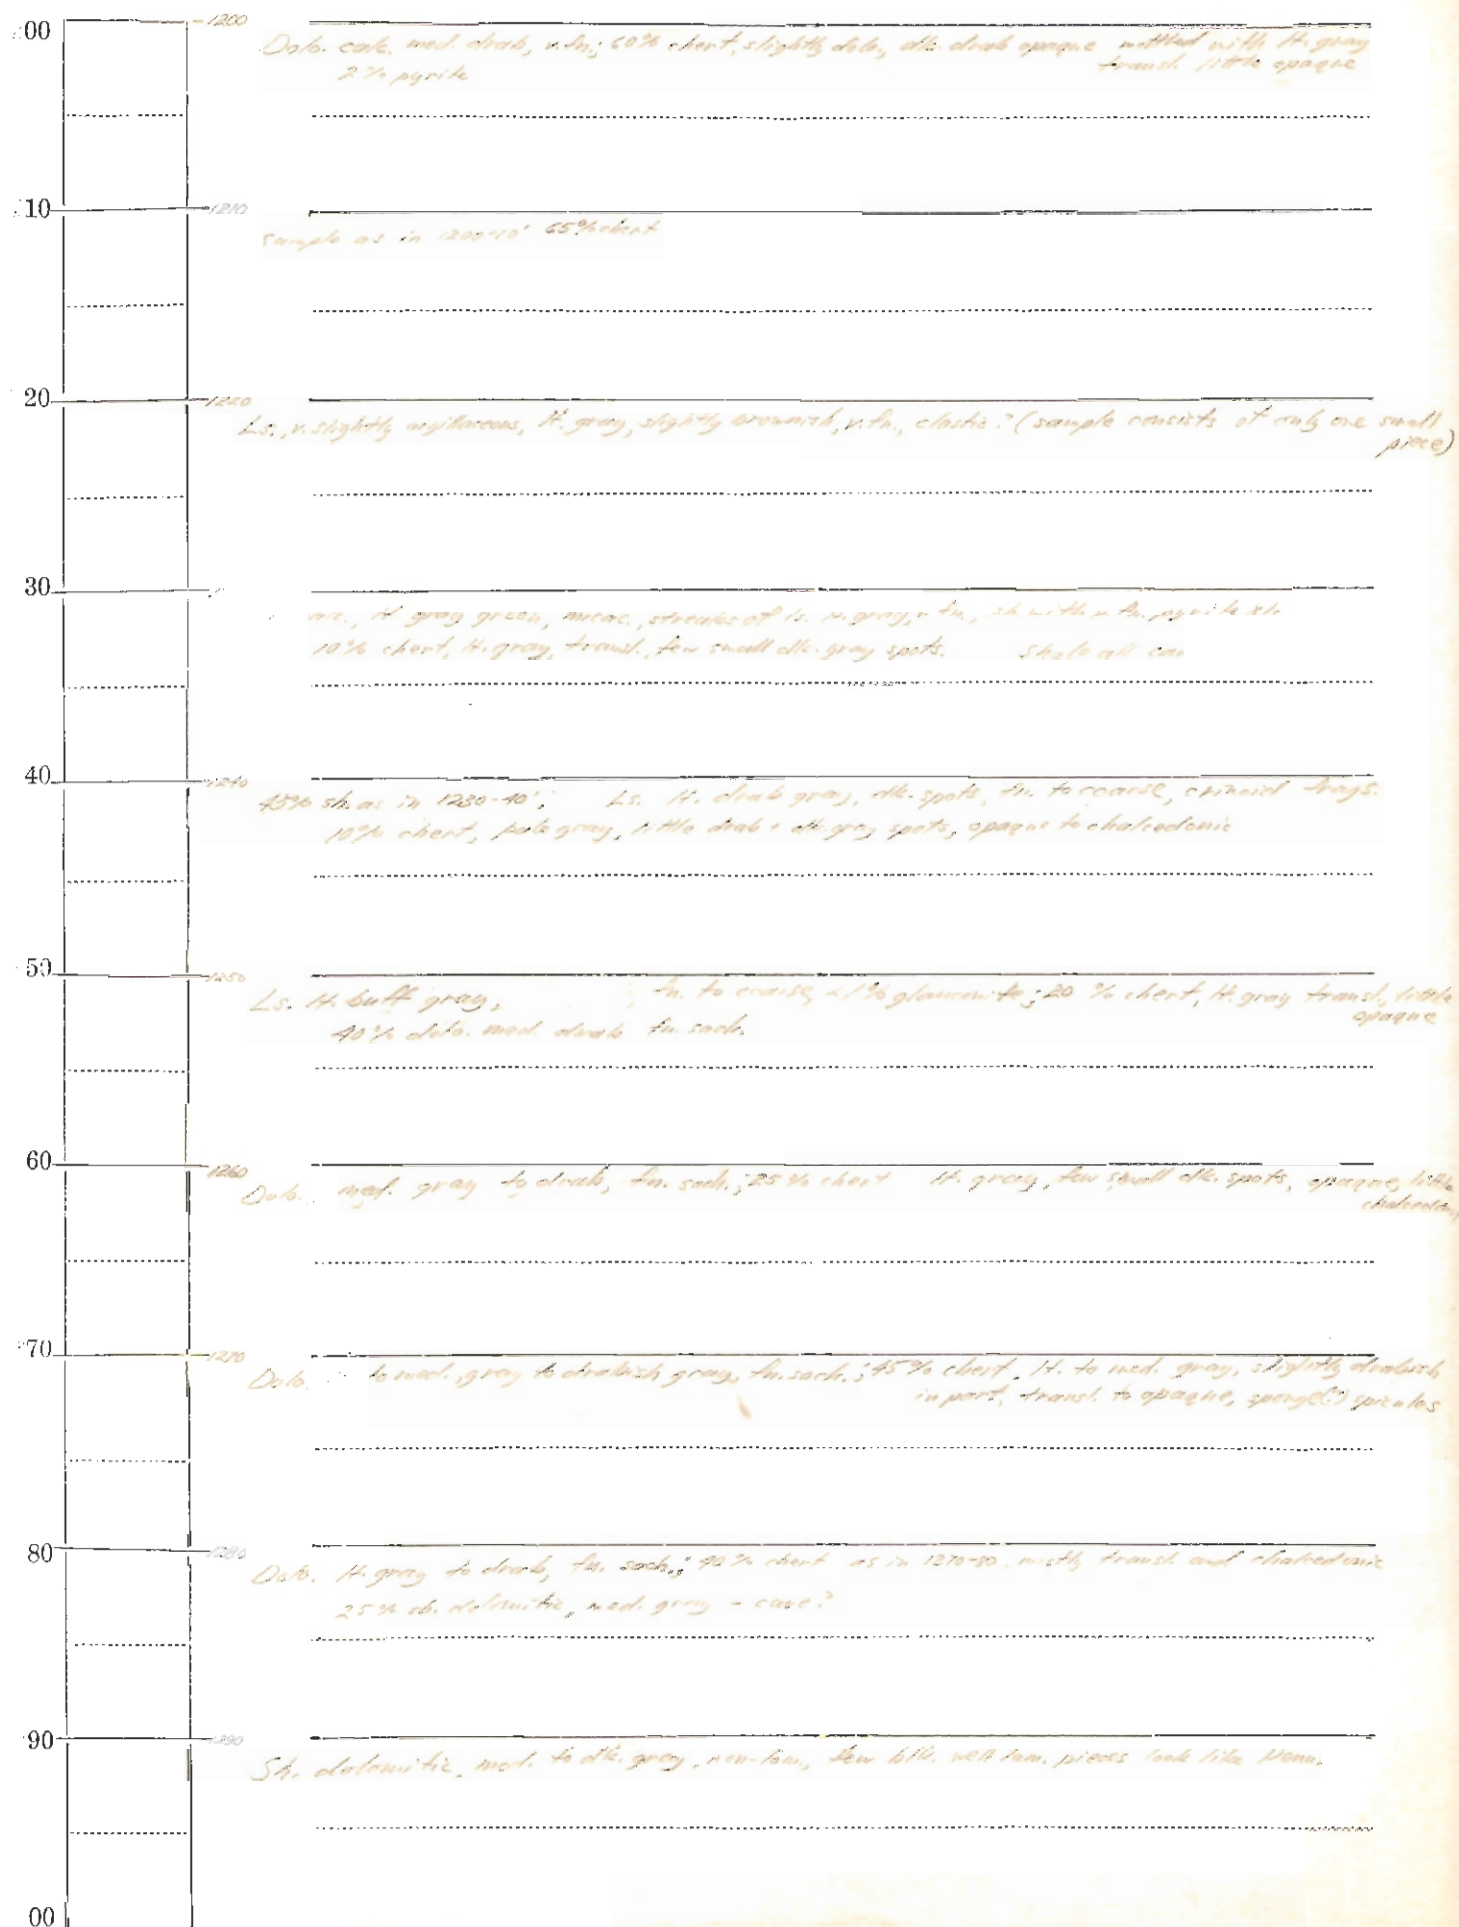

Location Pottowattamie Date Drilled Analyst M. Elias

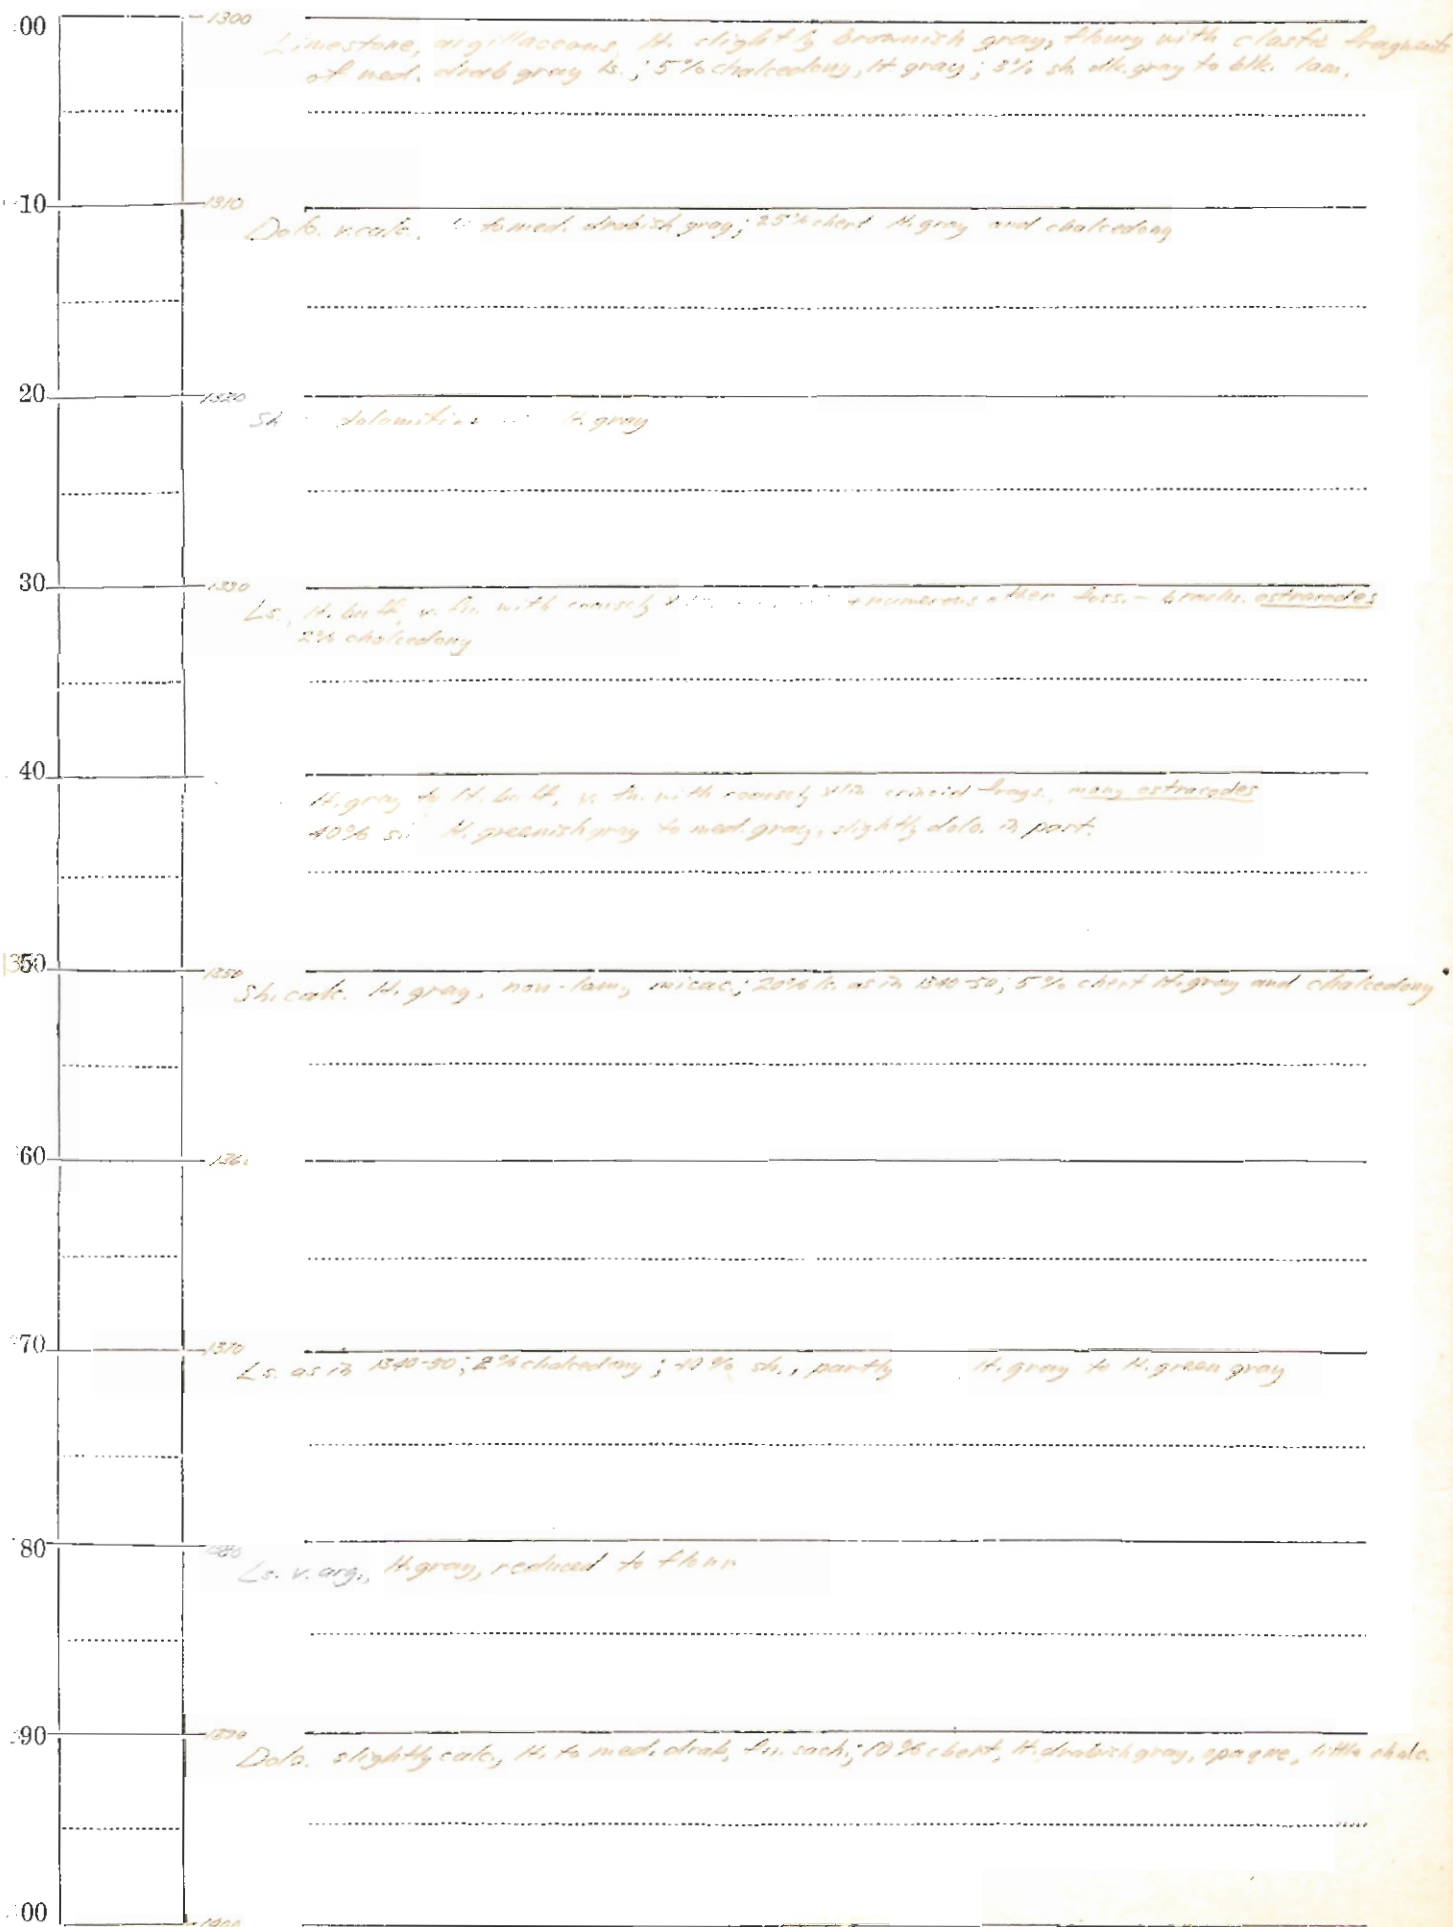

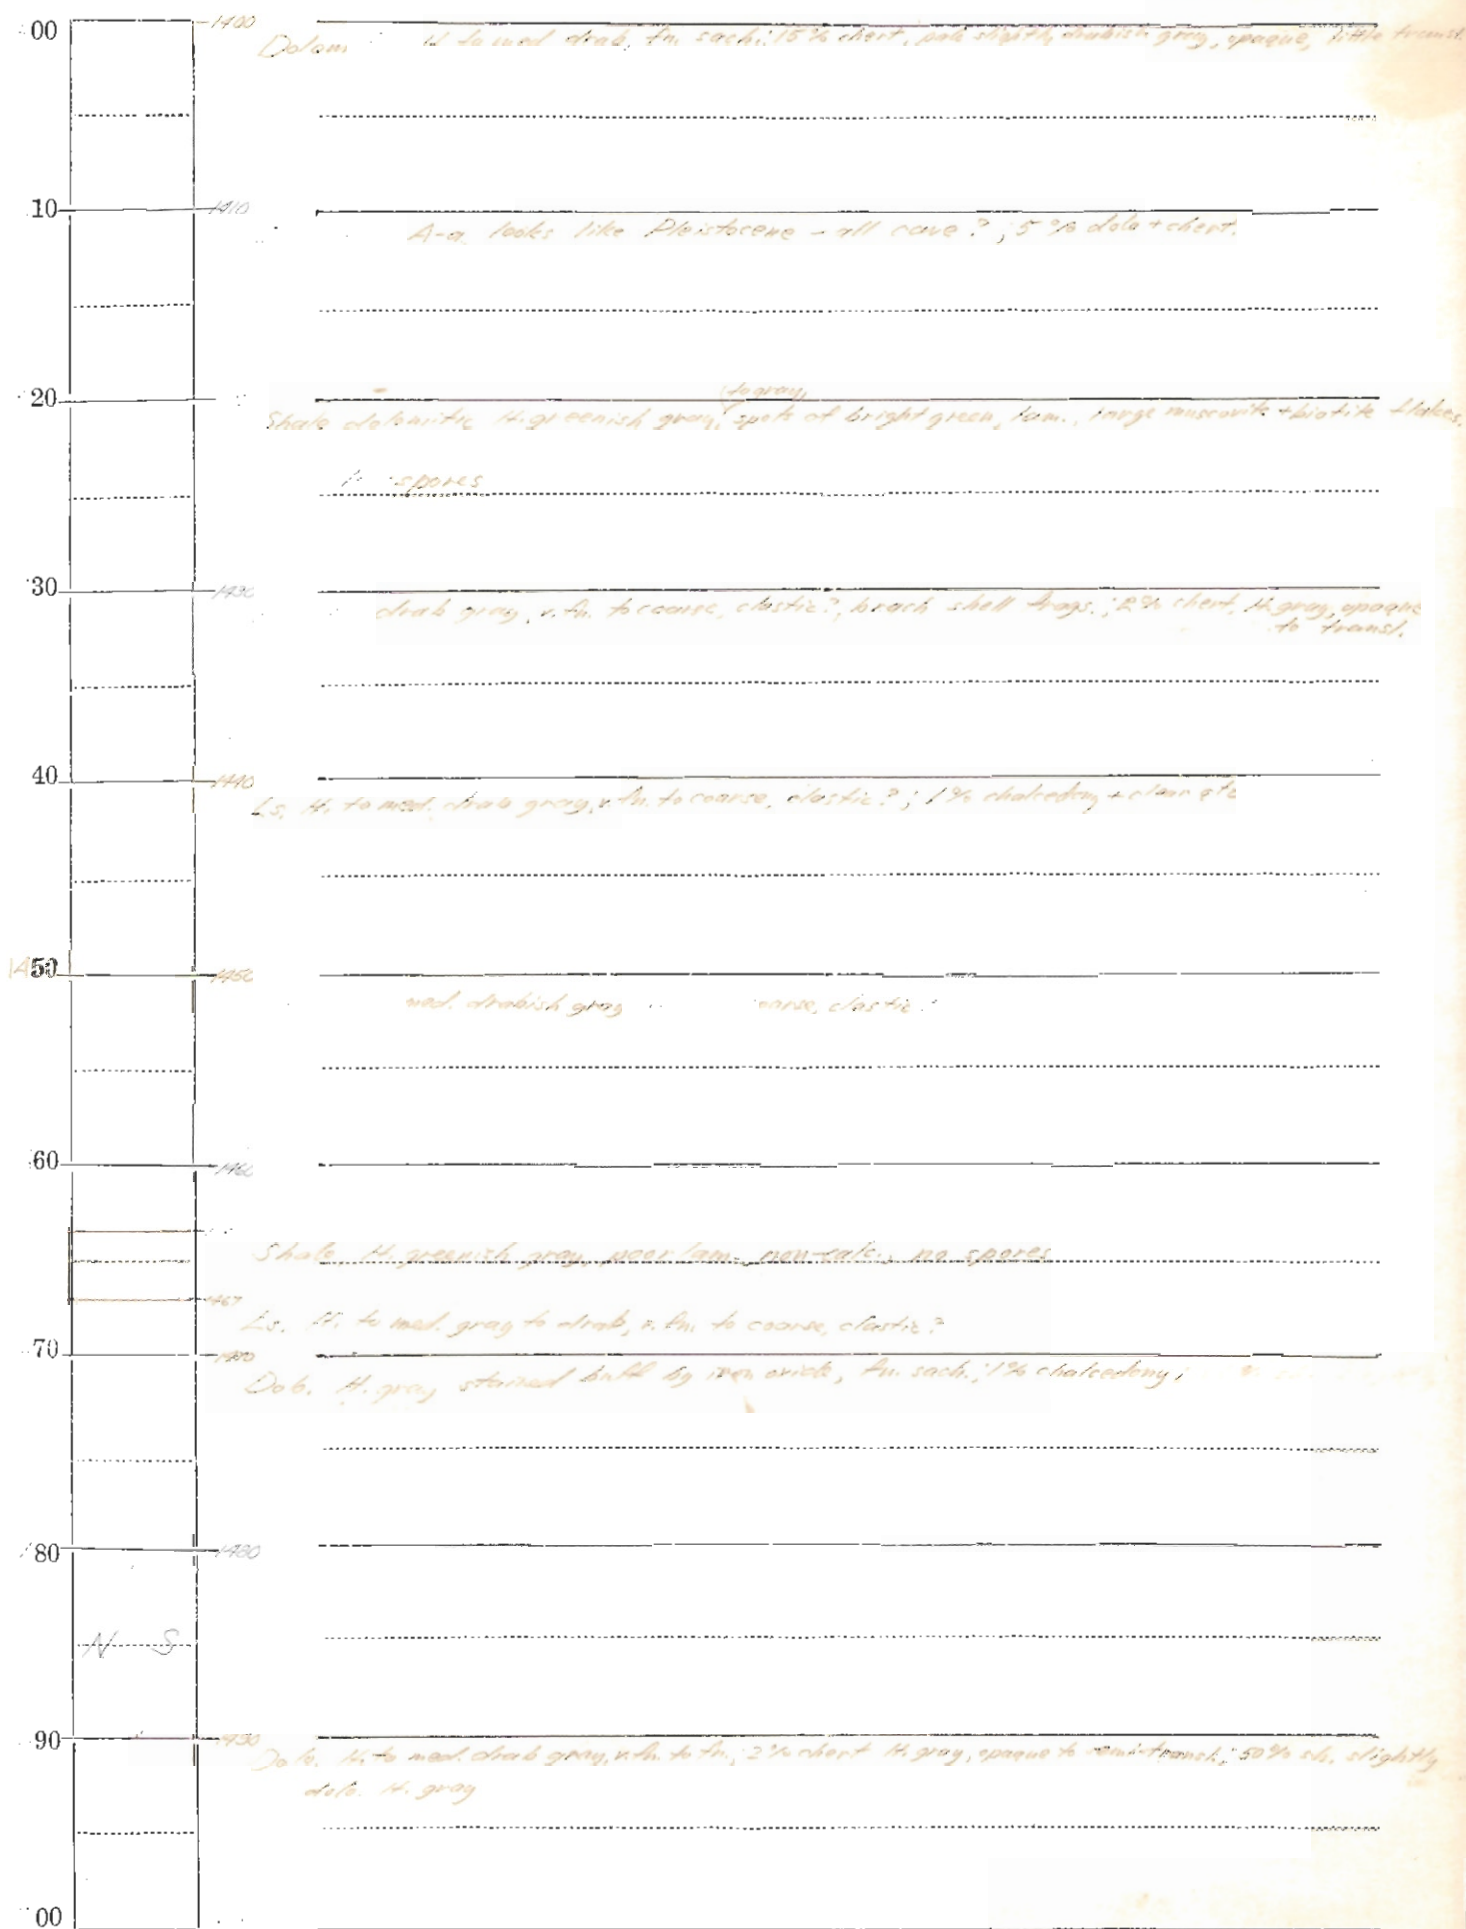


Sheet No.....5

Name of Well.. Oakland


Survey No. W-0213

Location Pottawattomie

Date Drilled

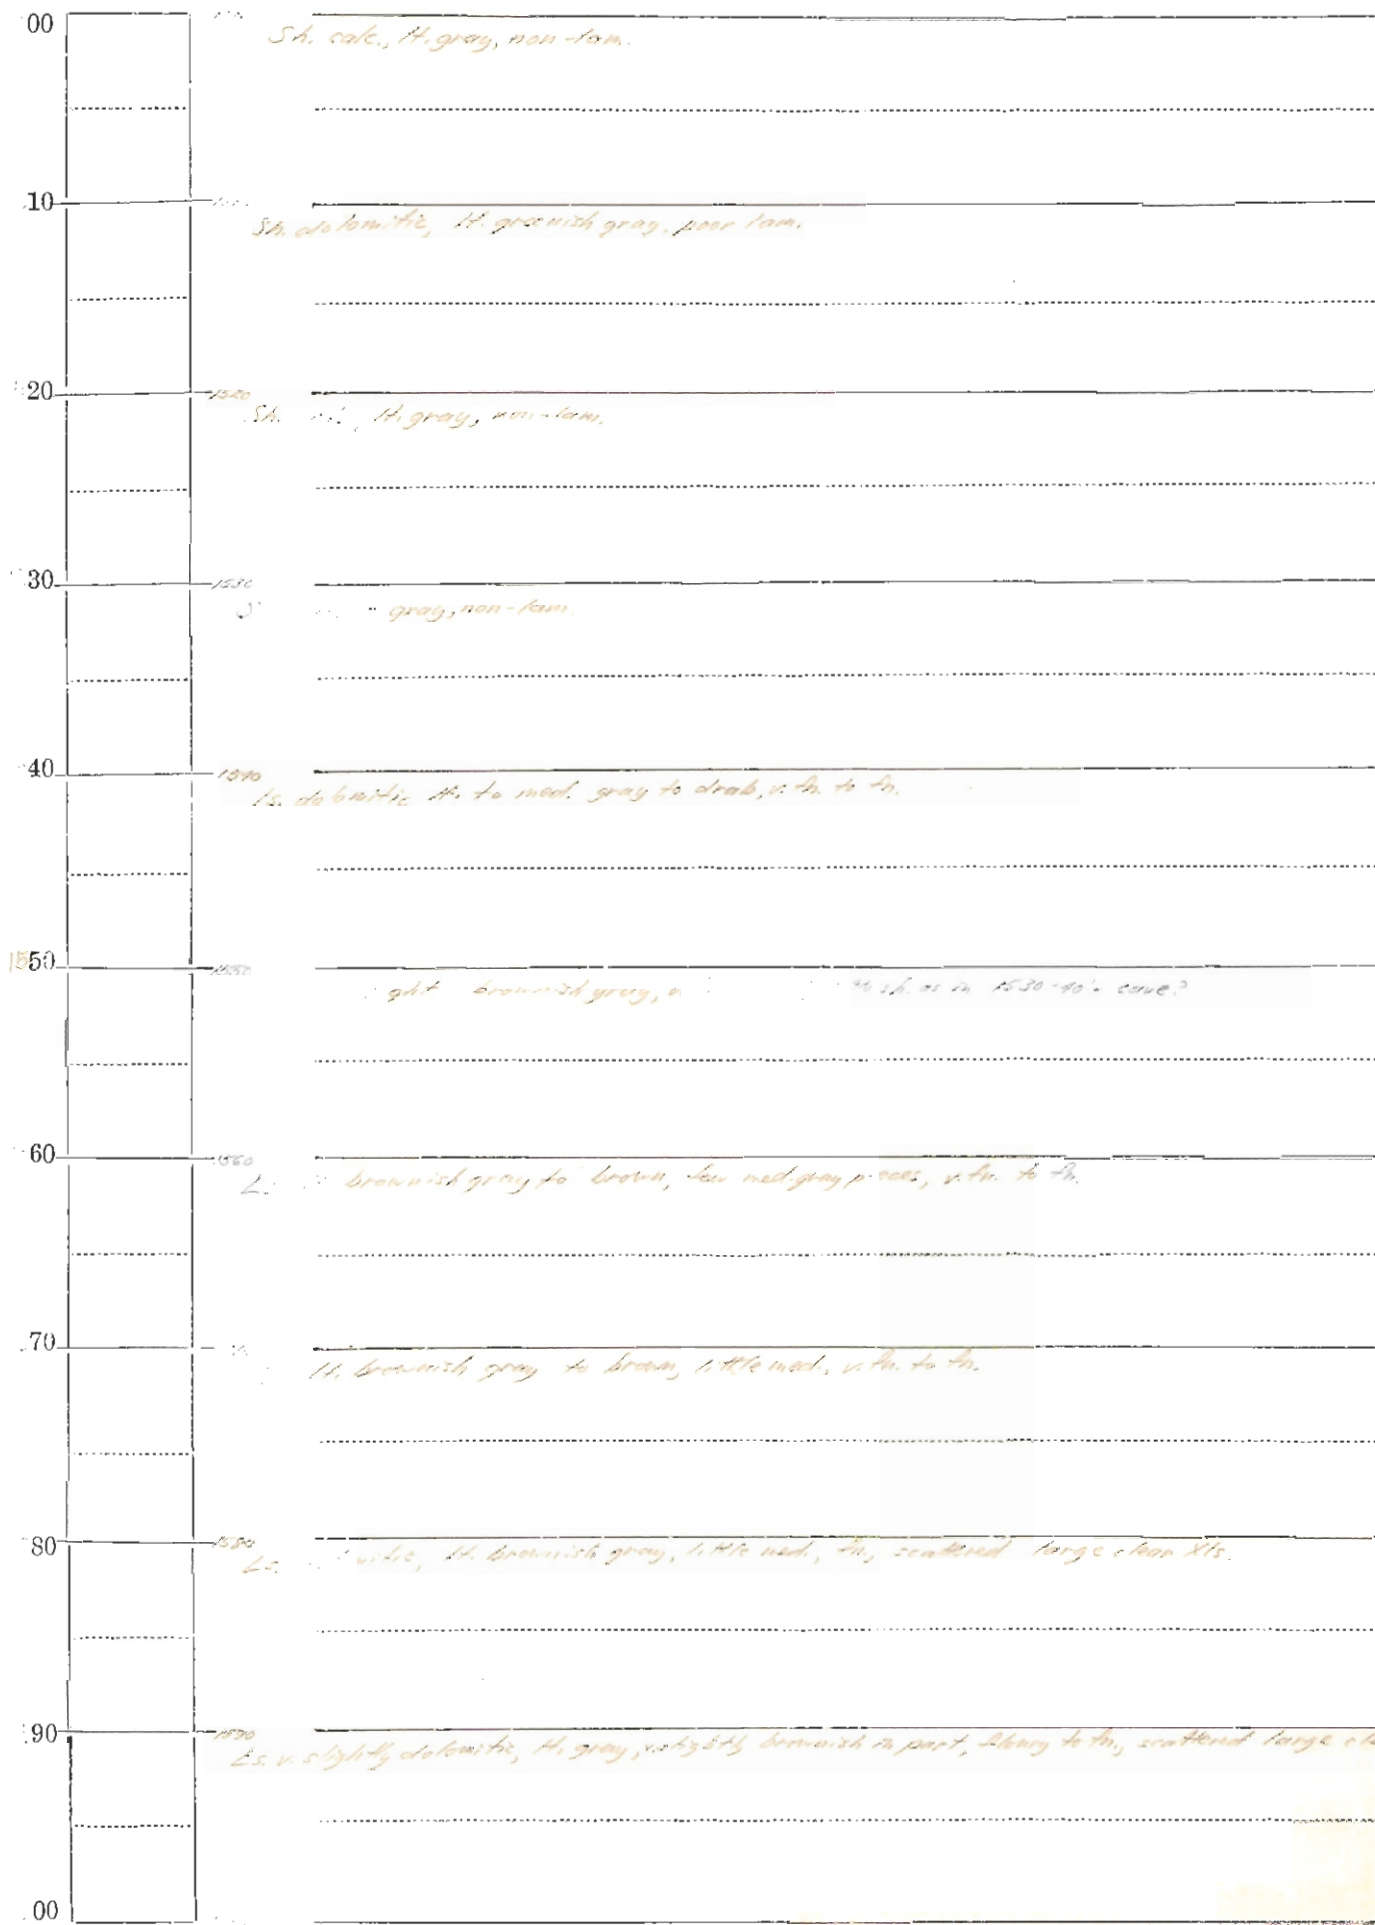
Analyst MEH

Location Pattawattmie Co Date Drilled _____ Analyst M. Elias

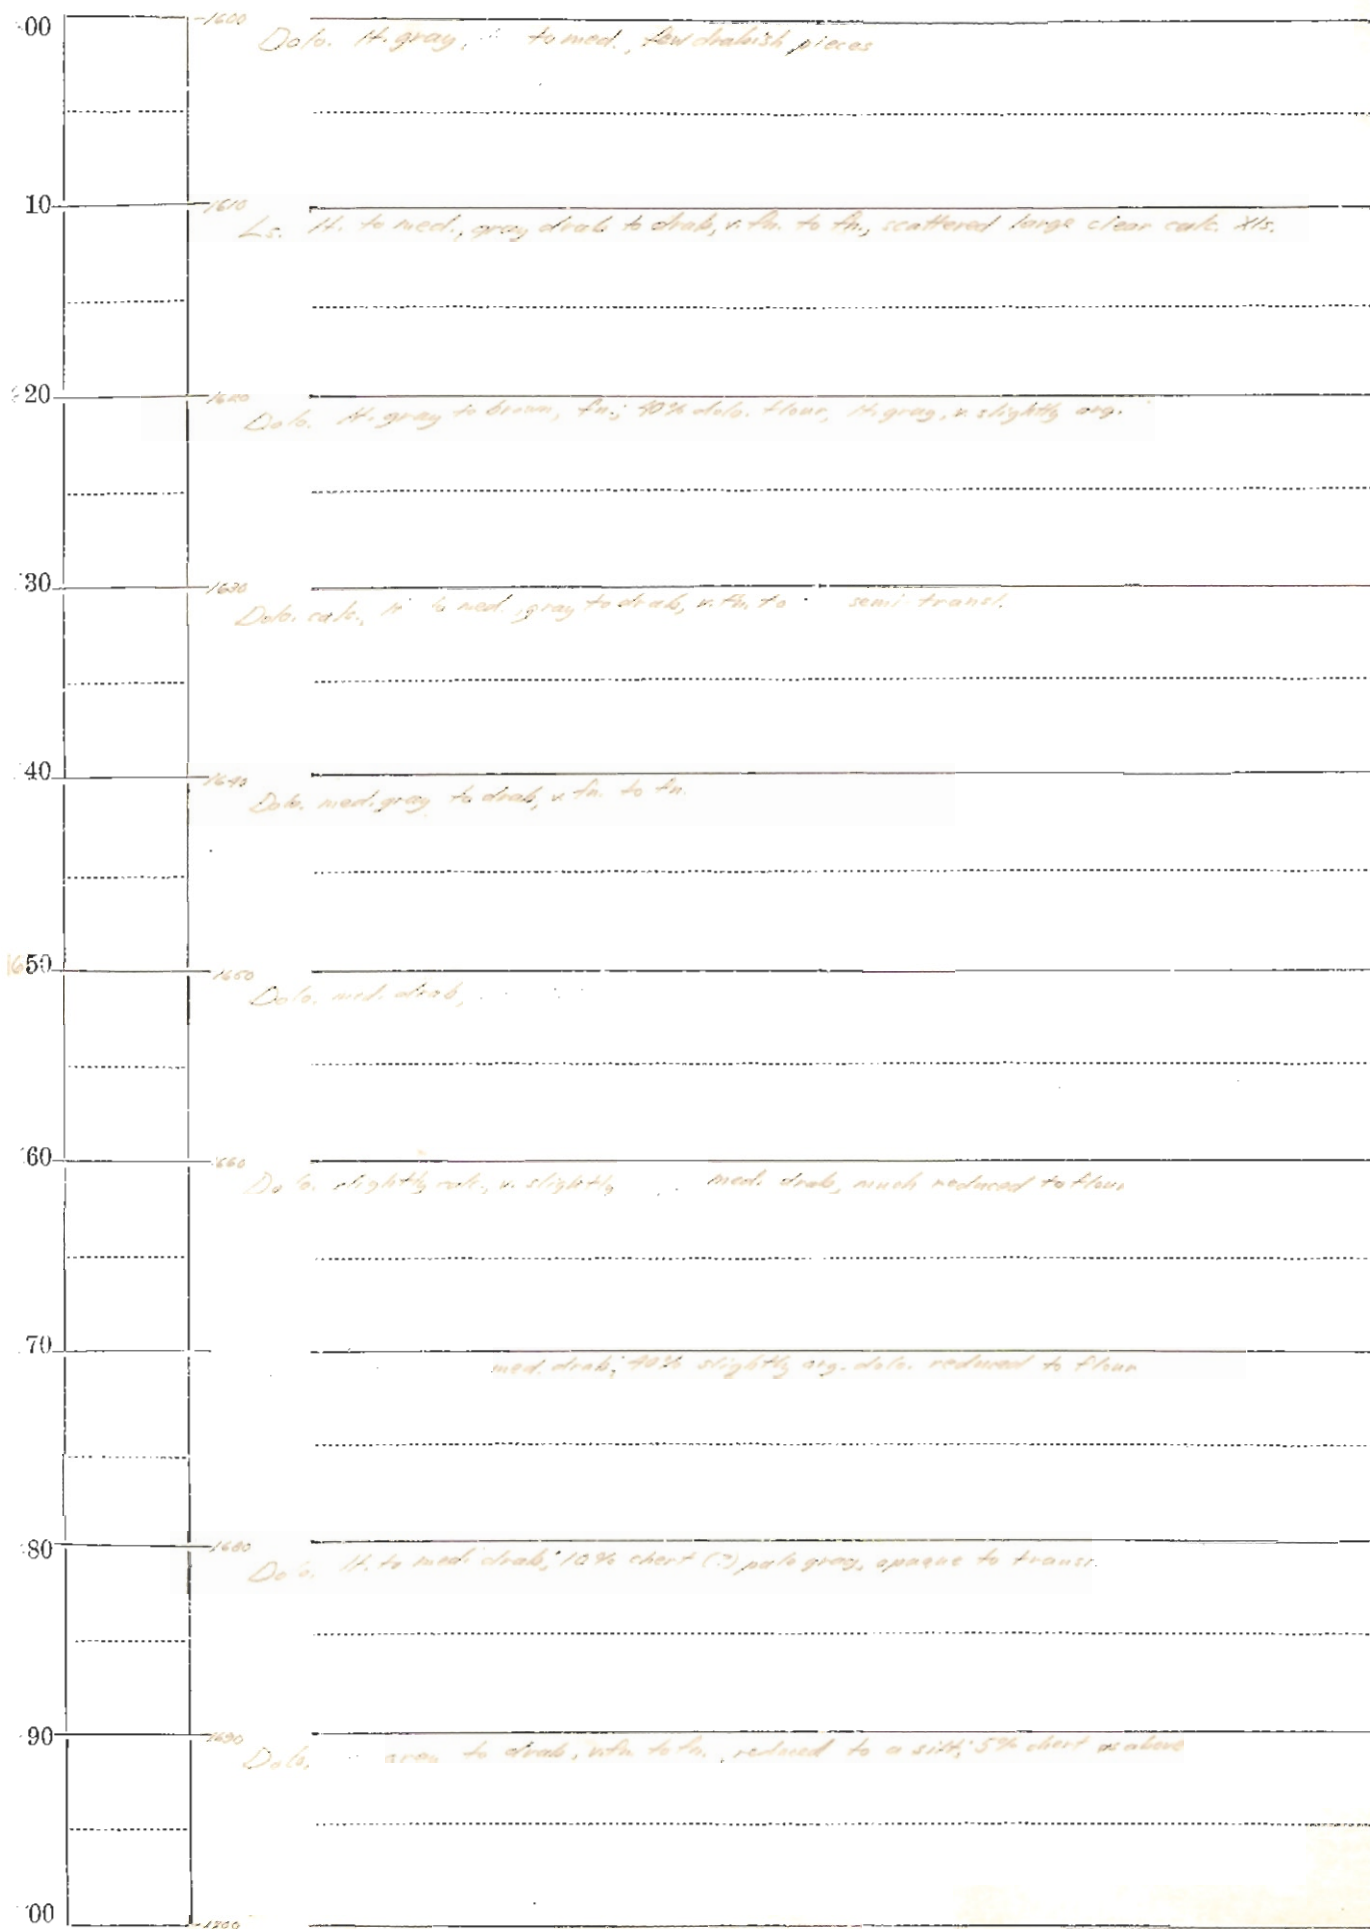


Sheet No. 7 Name of Well Oakland Survey No. W-0213

Location Pottawattomie Co. Date Drilled..... Analyst M. Elias

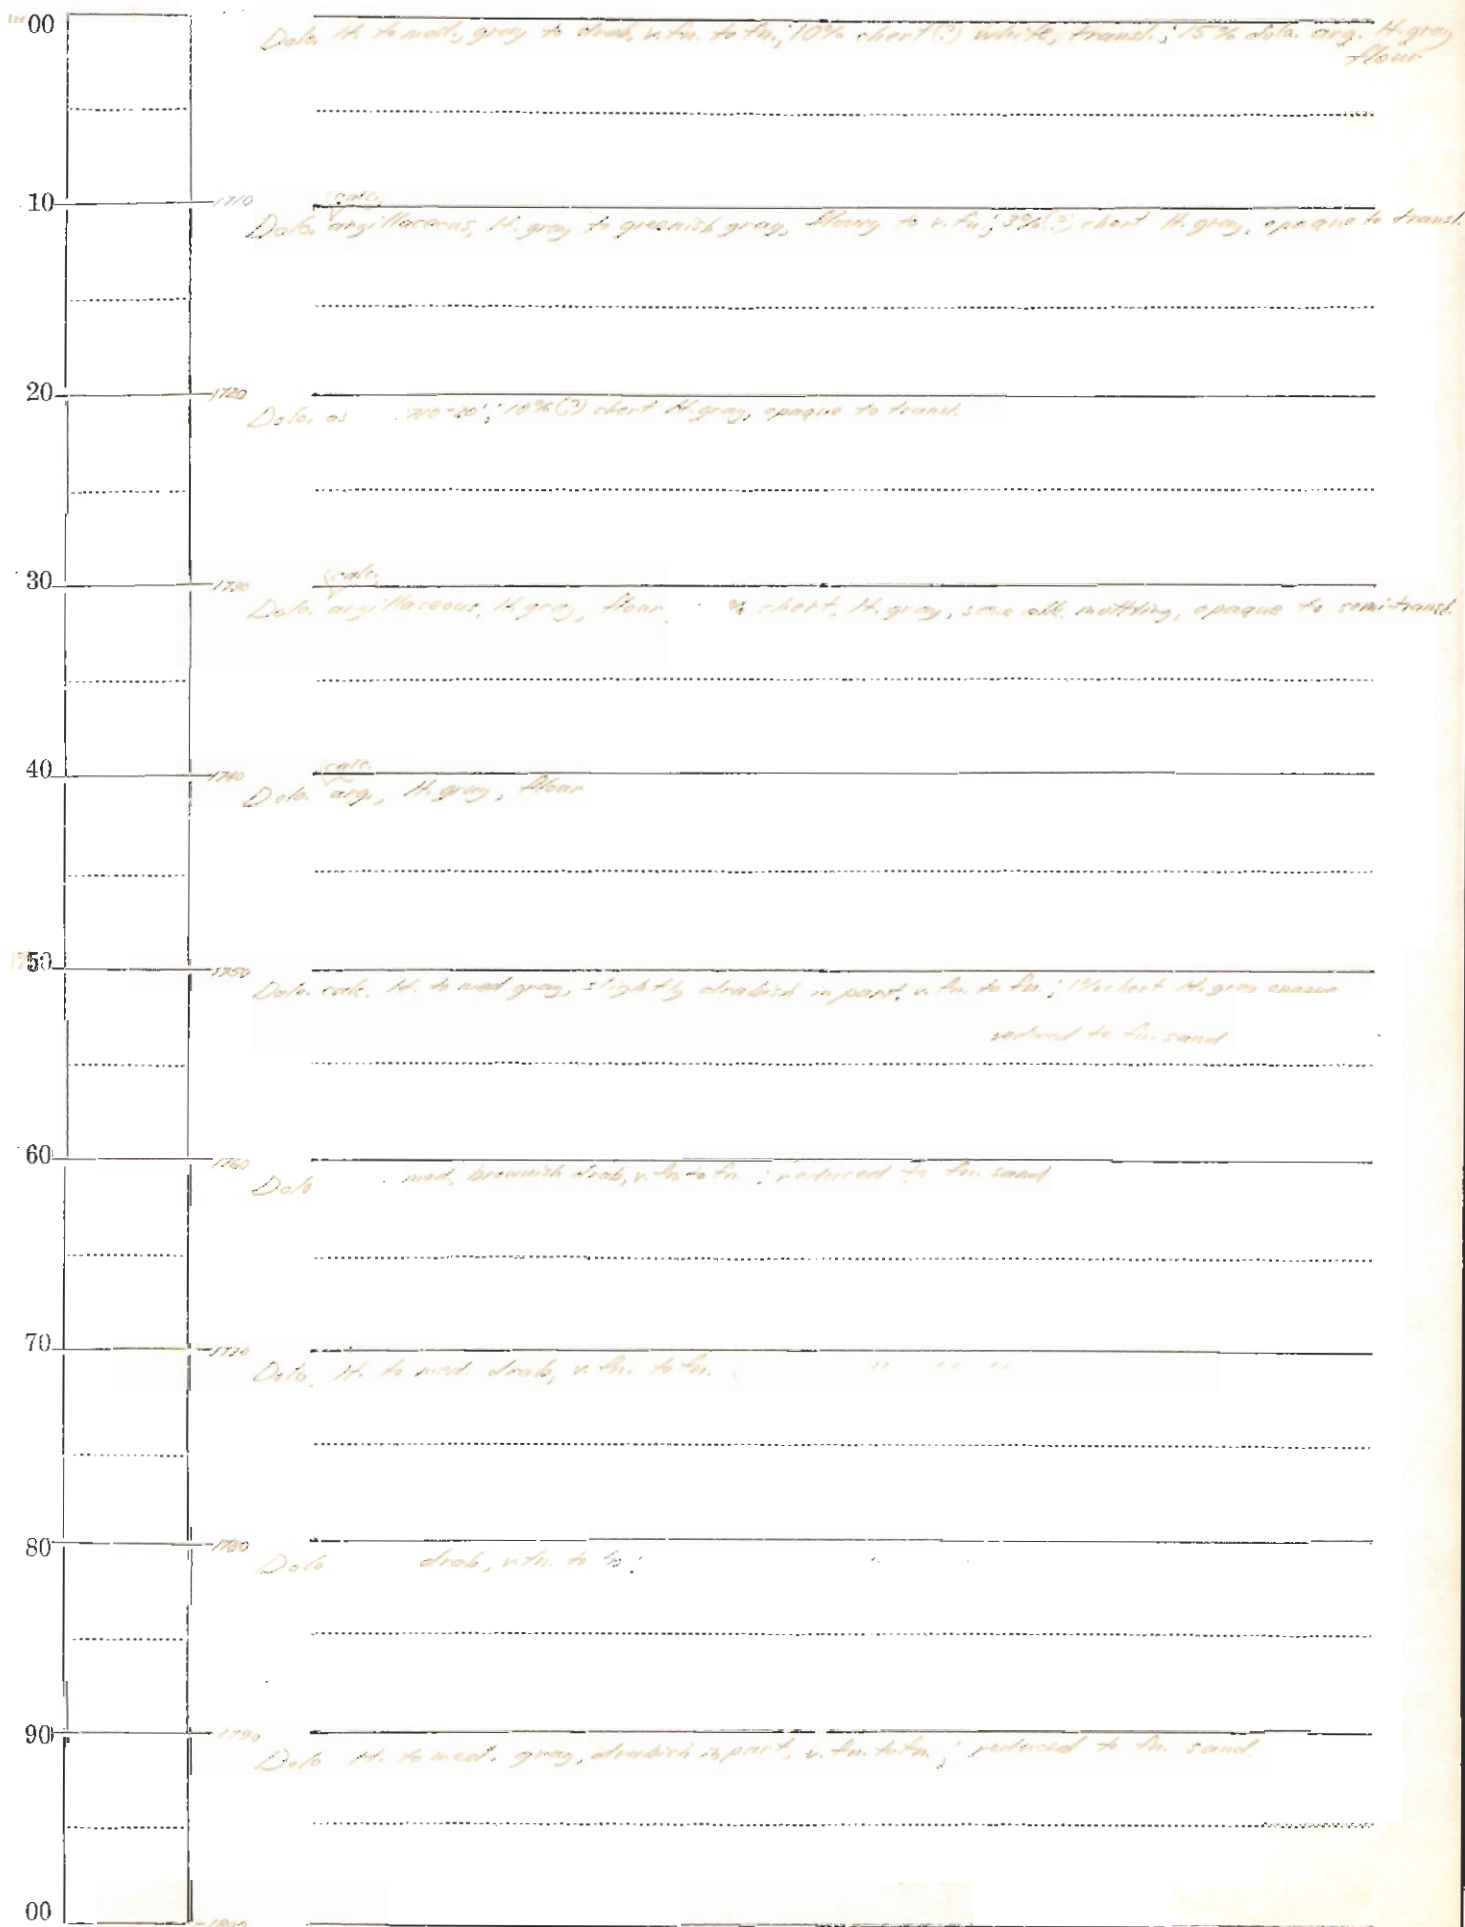


Sheet No. 10 Name of Well Oakland Survey No. 112212

Location Pottawatomie Co. Date Drilled Analyst M. Elias

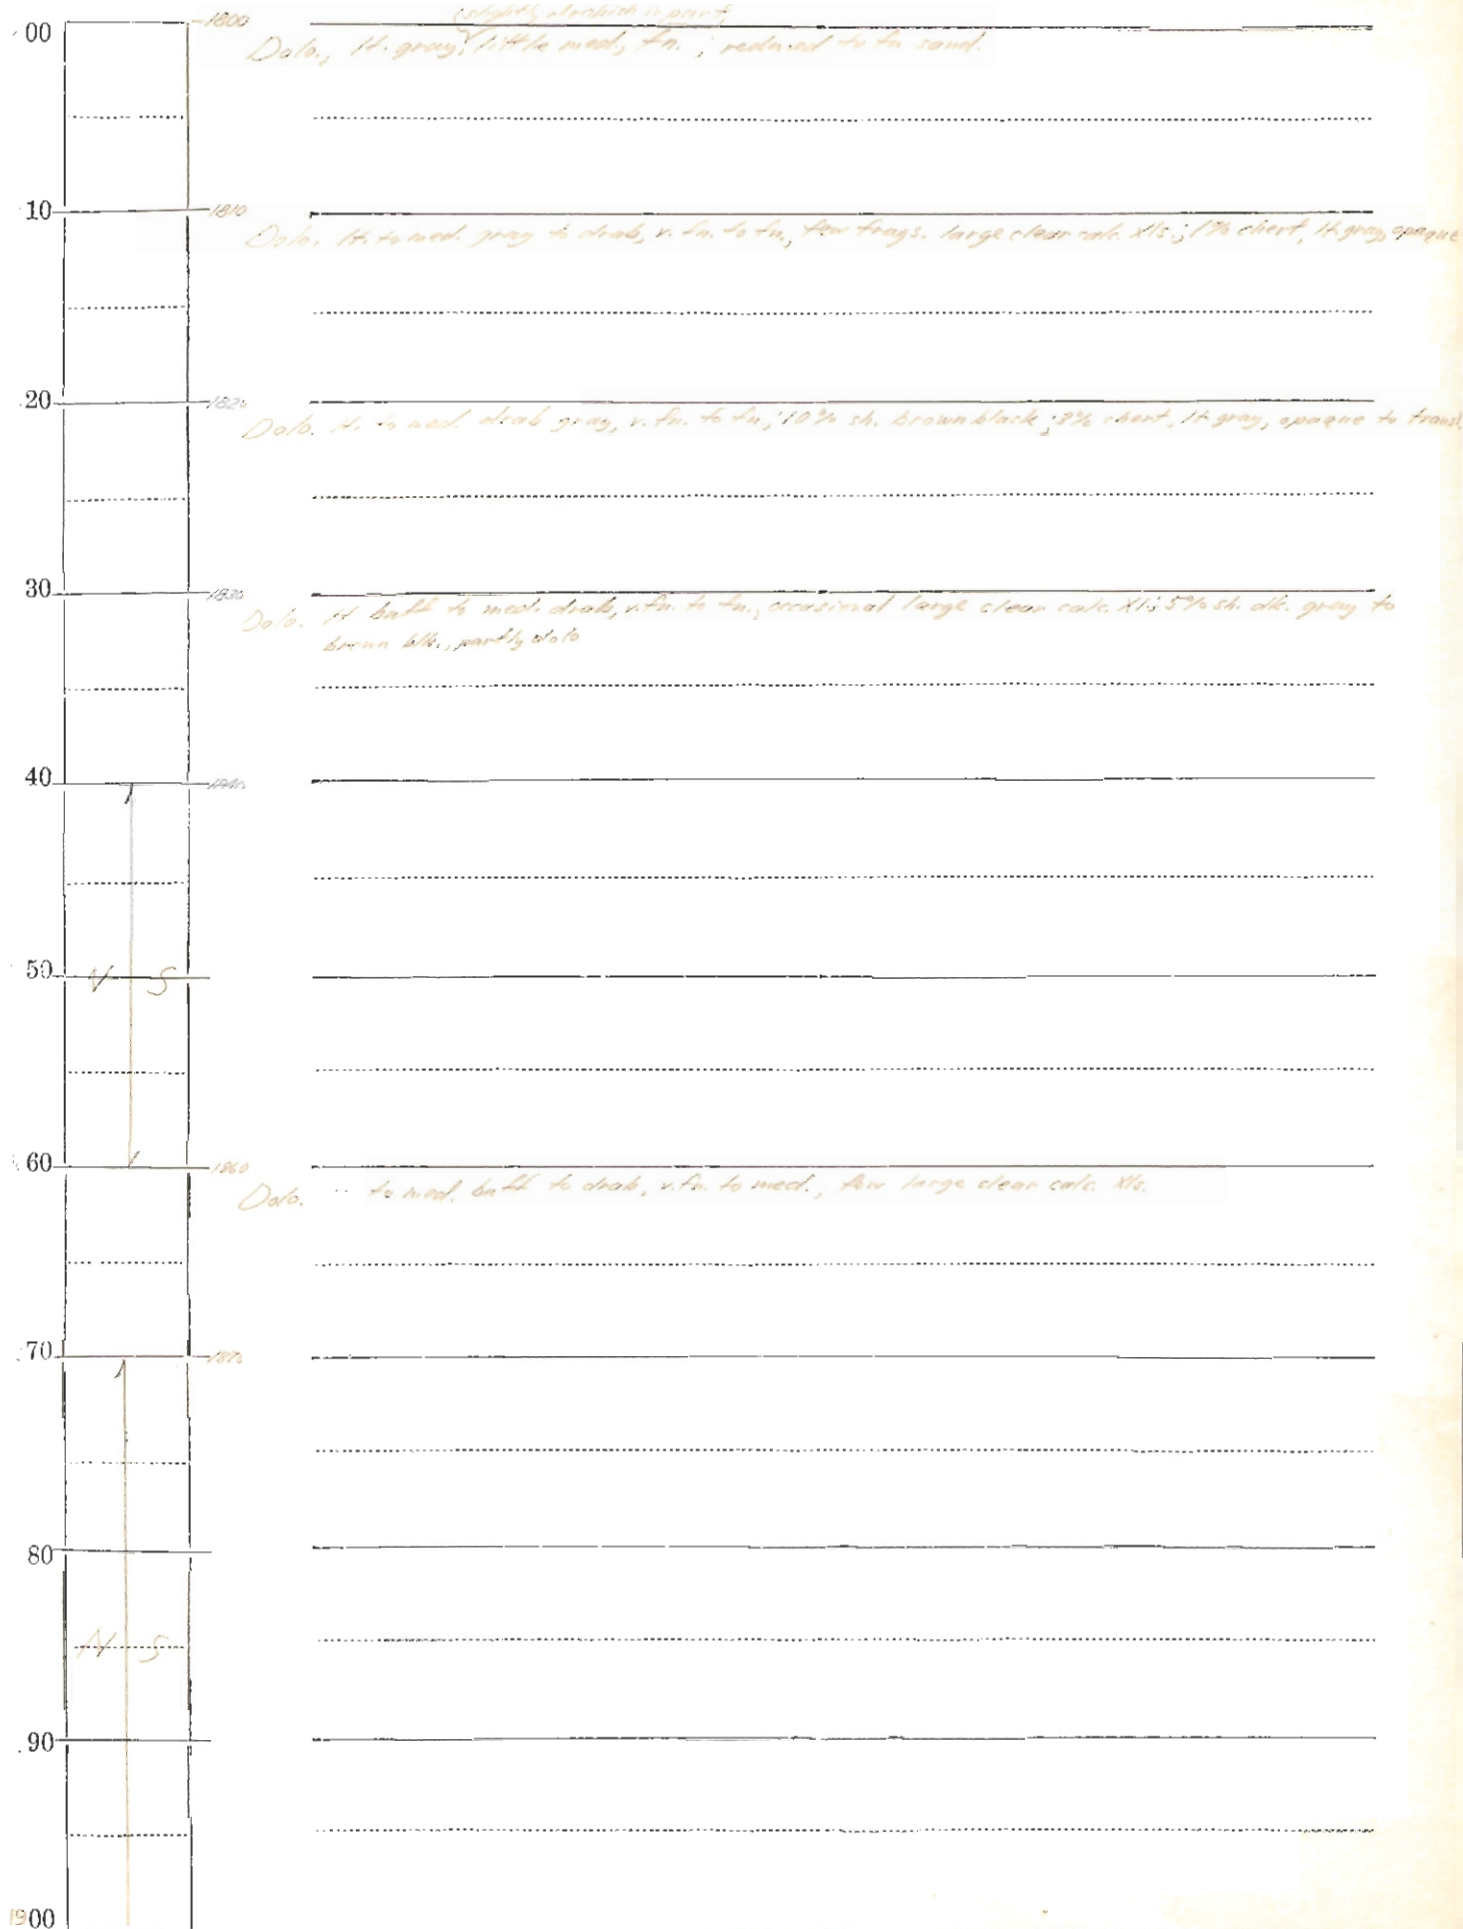

Sheet No. 2 Name of Well Oakland Survey No. W-0219

Location Butterworth Co Date Drilled _____ Analyst M. Elias

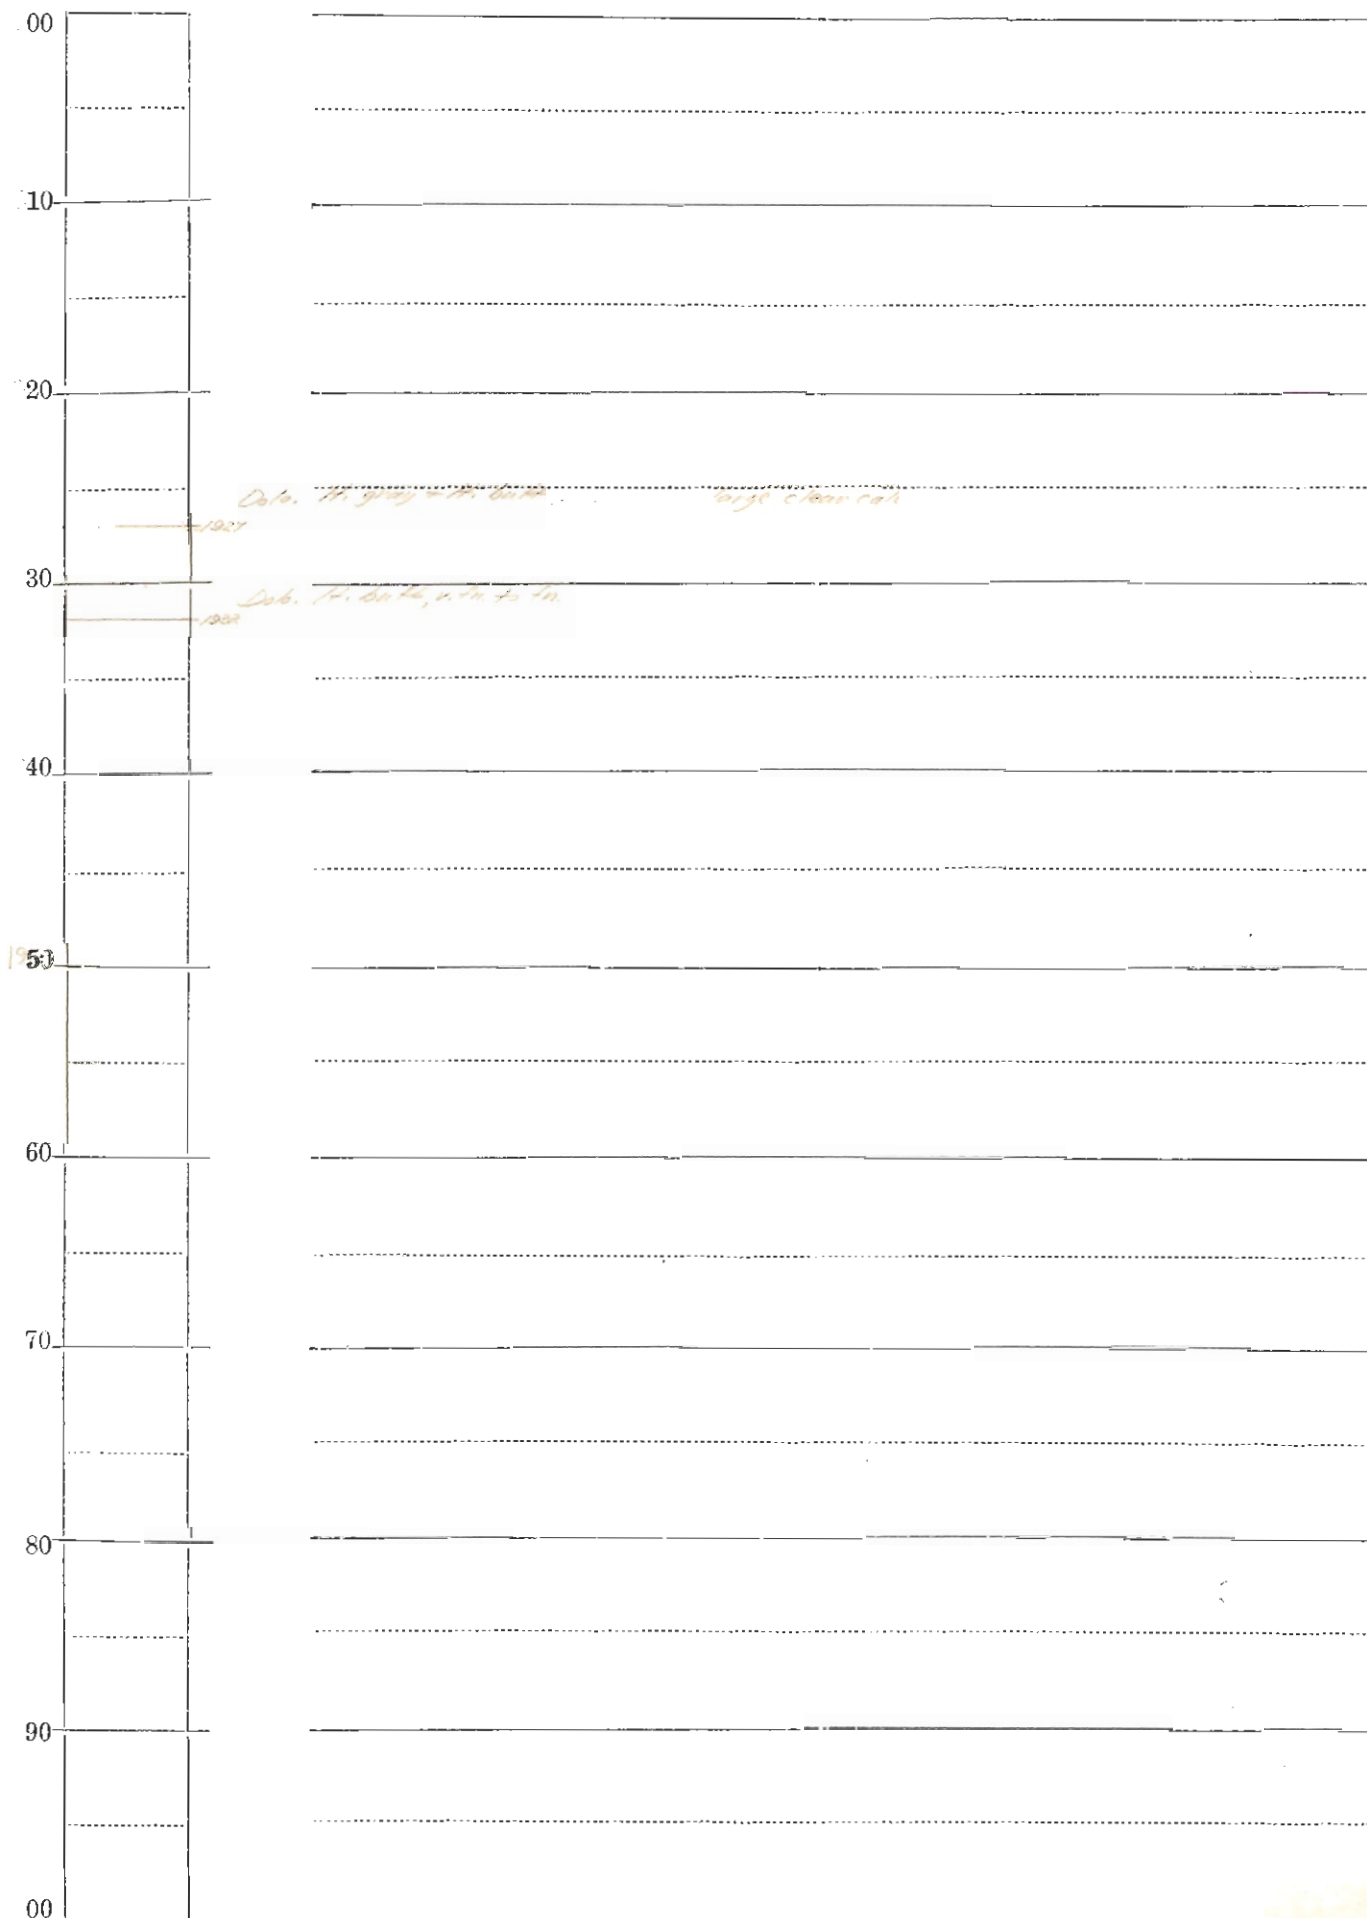

UNITED STATES DEPARTMENT OF THE INTERIOR

Geological Survey
Water Resources DivisionLocal Well No. 075-40W-12 CBAAquifer Code(s) D2MWWater Quality
(ppm)Owner's Name OAKLAND CITY WELL (1918)W Number 00213

Card Q

State: Iowa 19 County: POTTAWATTAMIE 78 Town: OAKLAND, IOWA

Well No. 411836N 0952400 Seq. No. 1 Date 102334

Sampling Depth 1936 Type 1 Kx10⁶ pH 7.4 Temp. °F

SiO₂ Ca 81 Mg 38 Na 346 K Source No. 3 Q

HCO₃ 317 CO₃ SO₄ 666 Cl 138

Card R

Duplicate Columns 1-25 from Card Q

F 40 NO₃ 0 PO₄ B Al Fe 16

Mn 0 Cu Pb Zn

Determined 1530 Solids Calc. Ca, Mg 359 Hardness Non-Carb. 99

Color No. R

Card S

Duplicate Columns 1-25 from Card Q

Br I Alk. as CaCO₃ 260 Free CO₂ SAR

RSC ABS

Alpha (pc/l) Beta (pc/l) Ra (pc/l) U (ug/l)

No. 5
80Recorded by: D. AARONSONPunched by: Date: Published:

UNITED STATES DEPARTMENT OF THE INTERIOR

Geological Survey
Water Resources DivisionLocal Well No. 075-40W-12 CBAAquifer Code(s) D2MWWater Quality
(ppm)Owner's Name OAKLAND CITY WELL (1918)W Number 00213

Card Q

State: IOWA 19 County: POTTAWATTAMIE 78 Town: OAKLAND, IOWA

Well No. 411836N 0952400 Seq. No. 1 Date 031435

Sampling Depth 1936 Type 1 Kx10⁶ pH 7.5 Temp. °F

SiO₂ Ca 80 Mg 38 Na 385 K

HCO₃ 332 CO₃ SO₄ 686 Cl 139 Source No. 3Q

Card R

Duplicate Columns 1-25 from Card Q

F 37 NO₃ 0 PO₄ B Al Fe 4

Mn 0 Cu Pb Zn

Determined 1500 Solids Calc. Ca, Mg 356 Hardness Non-Carb. 84

Color No. R

Card S

Duplicate Columns 1-25 from Card Q

Br I Alk. as CaCO₃ 272 Free CO₂ SAR

RSC ABS

Alpha (pc/l) Beta (pc/l) Ra (pc/l) U (ug/l)

No. S
80Recorded by: D. AARONSONPunched by: T Date: Published:

UNITED STATES DEPARTMENT OF THE INTERIOR
Geological Survey
Water Resources Division

075-40W-12 CBA

DMW

1-0213

Water Quality
(ppm)

Card Q

State: IOWA 1 4 County: POTTAWATTAMIE 7 8 Town: OAKLAND

Latitude Longitude Seq. No. Date

Well No. 4 1 1 8 2 6 N 0 8 5 2 4 0 0 1 0 2 1 2 6 2

Sampling Depth 1 9 3 0 Type 1 Kx10⁶ 2 8 4 0 pH 7 3 Temp. °F 6 1

SiO₂ 1 9 1 Ca 5 0 Mg 3 8 1 Na 5 1 2 1 K 1 9 1

HCO₃ 5 0 8 CO₃ 0 SO₄ 6 2 1 Cl 2 4 2 1 Source No. 3 Q

Card R

Duplicate Columns 1-25 from Card Q

F 5 2 NO₃ 9 4 PO₄ 1 1 B 1 1 Al 1 1 Fe 2 7 1

Mn 8 0 5 Cu 1 1 Pb 1 1 Zn 1 1

Solids 1 8 6 0 Calc. 1 1 1 1 1 1 1 1 Ca, Mg 2 9 2 Hardness Non-Carb. 1 1 1 1

Color 1 1 No. R

Card S

Duplicate Columns 1-25 from Card Q

Br 1 1 I 1 1 Alk. as CaCO₃ 4 1 6 Free CO₂ 1 1 1 SAR 1 1 1

RSC 1 1 1 ABS 1 1 1 1 1 1

Alpha (pc/l) 1 1 1 Beta (pc/l) 1 1 1 Ra (pc/l) 1 1 1 U (ug/l) 1 1 1

No. 5
80

Verified PMJ

Recorded by: D. AARONSON

Punched by: Punched PMJ Date:
Published:

UNITED STATES DEPARTMENT OF THE INTERIOR

Geological Survey
Water Resources DivisionLocal Well No. 075-40W-12 CBAAquifer Code(s) D2MWWater Quality
(ppm)Owner's Name OAKLAND CITY WELL (1918)W Number 00213

Card Q

State: Iowa 19 County: Portsmouth 78 Town: OAKLAND, IOWA

Well No. Latitude Longitude Seq. No. Date

Sampling Depth Type Kx10⁶ pH Temp. °F

SiO₂ Ca Mg Na K Source No.

HCO₃ CO₃ SO₄ Cl

Card R

Duplicate Columns 1-25 from Card Q

F NO₃ PO₄ B Al Fe

Mn Cu Pb Zn

Solids Hardness Non-Carb.

Determined Calc. Ca, Mg

Color No.

Card S

Duplicate Columns 1-25 from Card Q

Br I Alk. as CaCO₃ Free CO₂ SAR

RSC ABS

Alpha (pc/l) Beta (pc/l) Ra (pc/l) U (ug/l)

No. 5
80Recorded by: D. AARONSONPunched by: T Date: _____

Published: _____



THORPE WELL COMPANY

CONTRACTORS

LATEST ROTARY AND CABLE TOOL EQUIPMENT
THORPE PATENT GRAVEL PACKED WELLS

2340 SIXTH AVENUE
TELEPHONE 3-6107

PLEASE ADDRESS ALL REPLIES
DIRECT TO THE COMPANY
LOCK BOX 1376

DES MOINES, IOWA

Aug. 13th 1943

H.G. Hershey,
Iowa Geological Survey,
Iowa City, Iowa,

Dear Sir:

Referring to your letter in regard to log of the deep well drilled for the City of Oakland we wish to advise that we donot have a log of this well, evidently this was among some of the records which were destroyed.

Very tfully yours,
Thorpe Well Company

By 