

66400

Sargent Drilling
INDUSTRIAL ENGINEERING
COMPLETE MUNICIPAL AND INDUSTRIAL
WELL AND PUMP SERVICE

PO Box 387
Geneva, NE 68361-0367

848 South 13th St.

Phone: (402) 759-3902
1-888-496-3902

TEST HOLE LOG

CUSTOMER: West Central Iowa RWA	
WELL ID: Monitoring Well 2006-1	
LOCATION:	
LATITUDE: 41° 52' 38.8"	
LONGITUDE: 095° 05' 03.4"	
FOOTAGES:	
DATE: 2-9-06	DRILLED BY: Derek

SWL:

PWL:

from feet - to feet

0	20	Top soil and clay
20	25	Clay
25	40	Fine and medium gravel and medium and coarse sand with cobbles
40	48	Fine to medium gravel and medium and coarse sand
48	55	Clay

Well Depth: 48'

Bore Hole: 7"


Plain casing: 20' of 2"

Perf. casing: 28' of 2"

Gravel pack from 25' to 48'

Bentonite from 0' to 25'

66400

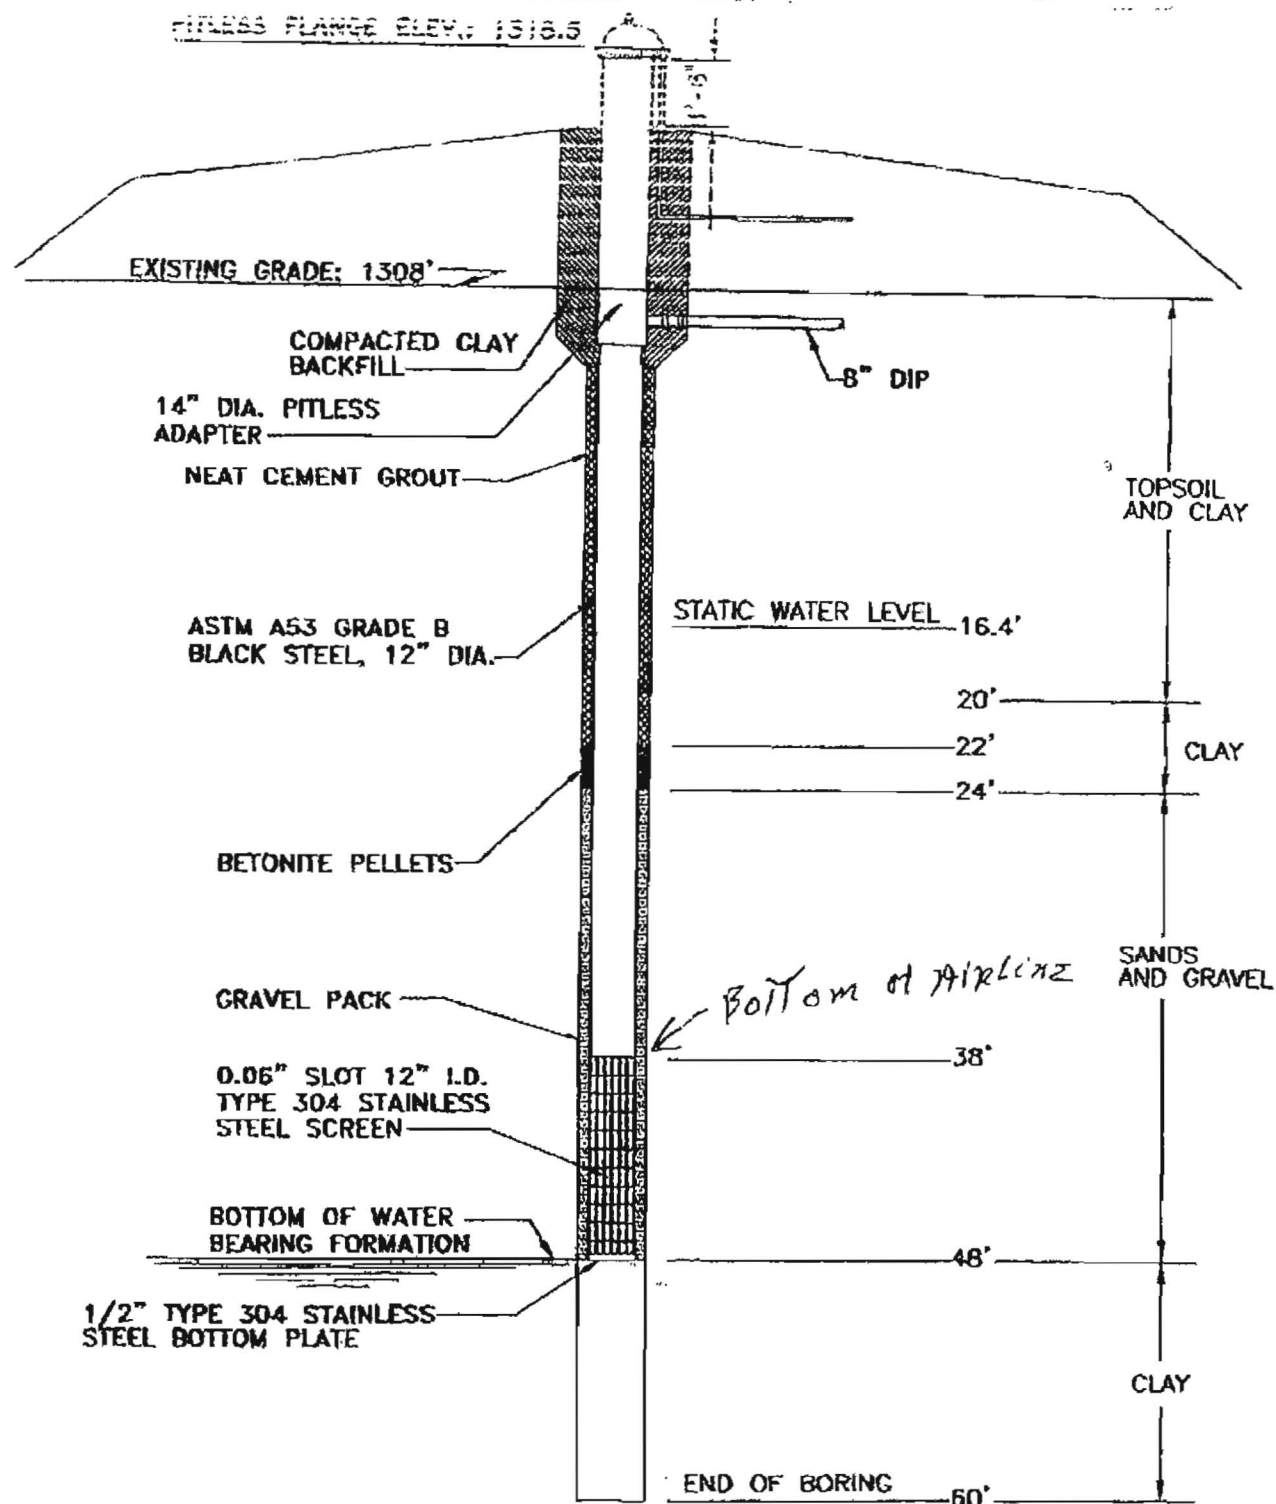

SECTION VIEW
PRODUCTION WELL: ASBUILT
 NOT TO SCALE (02124060)

P:08\021\24\DWG\02124060.DWG

SHEET NO. 4



Delinda Grant, Richard and Associates Company
 Consulting Engineers
 Rock Rapids, Iowa
 Spirit City, Iowa
 Sioux Falls, South Dakota

Date APR 2006
 Drawn By JMG
 Approved LJT
 Revised
 PROJECT NO. 002124

WELL N-8 PROJECT
 WEST CENTRAL IOWA RWA
 MANNING, IOWA

Manning WCIRW

03/06/2009 14:25 7126553151 WCIRWA PAGE 04/04