


As-Built Well #8 Construction Detail
City of Graettinger, Iowa
August 14, 2020

94944

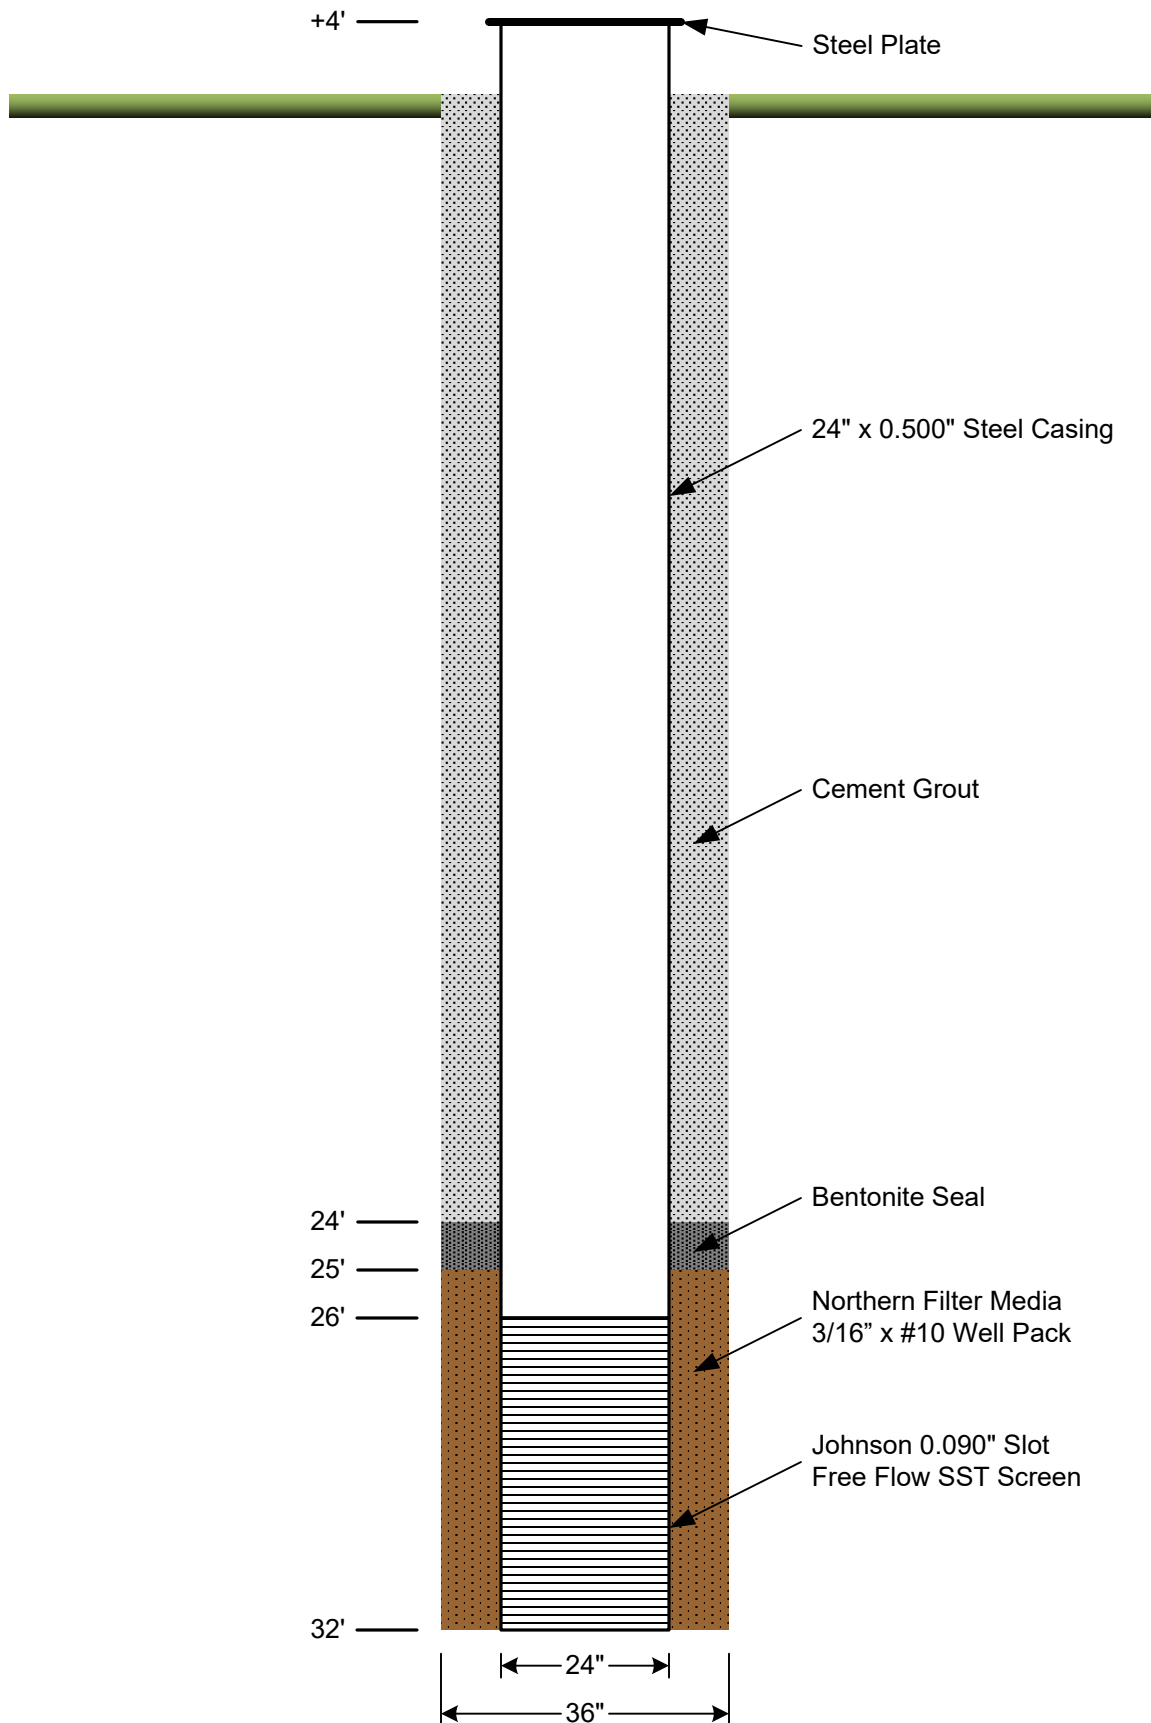

Not To Scale

COMMENTS: